


Sumner

Form 51-5M-4-27-27423

Map No. **KANSAS** Sec. *35* Twp. *30* R. *2^W*

Well No. *2-Grants* Farm
DeForest Drilg. Company

NORTH

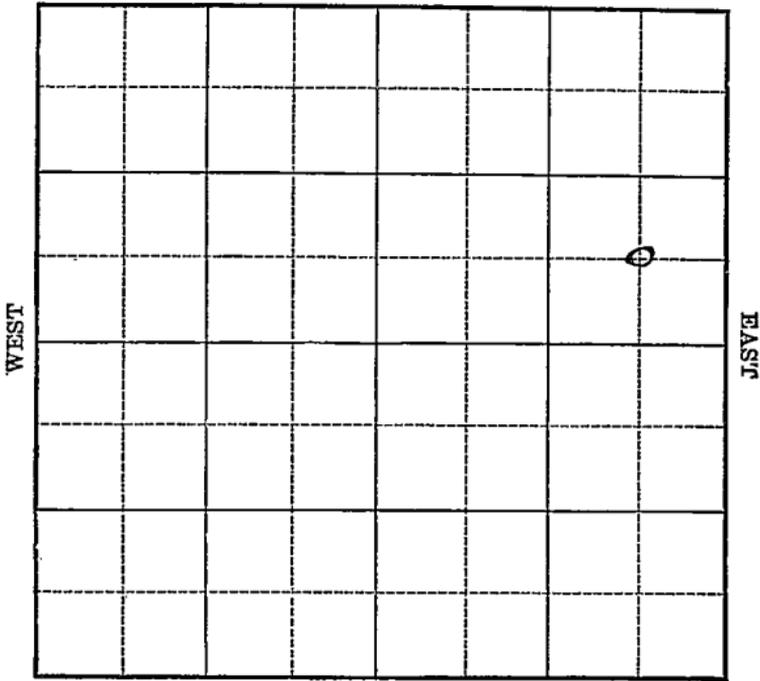

SOUTH

Location _____

Drilling Remarks _____

Rig Up _____

Drilling Remarks _____

RECORD

Cased _____ in. _____ ft.

Sand _____

Gas _____

Oil _____

Total Depth _____

PRODUCTION

1st 24 hrs. Nat. _____

1st 24 hrs. after shot _____


Gas _____ cu. ft.

Dry Hole _____

Abandoned _____

Map No. KANSAS Sec. 35 Twp. 30 R. 2 W
Well No. 2 - Frantz Farm
Deforest Drly Company

..... Ft. from N. Line
660 Ft. from S. Line
660 Ft. from E. Line
..... Ft. from W. Line

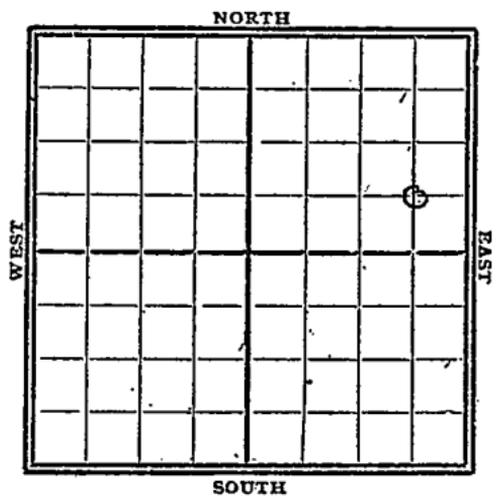

1928

| Date | REPORT |
|------|--------------------------|
| 8/22 | Mach. |
| 8/22 | Rig up. |
| 9/5 | Drly 1200' |
| 9/12 | " 1750 |
| 9/19 | sand 1926-29 = 3/4 A gas |
| 9/26 | sand 1926-1929' |
| | 1 A gas |
| | 900# R. P. |
| | Comp |

MAP No. **KANSAS** SEC. 35 TWP. 30 R. 2W

WELL No. 2 Frantz

Haywood & Co COMPANY
 _____ CONTRACTOR

SECTION PLAT

| | | | |
|--|--|--|---|
| | | | |
| | | | 0 |
| | | | |
| | | | |

_____ FT. FROM N. LINE

660 FT. FROM S. LINE

660 FT. FROM E. LINE

_____ FT. FROM W. LINE

FIRST REPORTS

LOCATION _____

RIG UP _____

DRILLING AND REMARKS:

Mach

RECORD

CASED _____ IN., _____ FT.

SAND _____

GAS _____

OIL _____

TOTAL DEPTH _____

PRODUCTION

1ST 24 HRS. NAT. _____

1ST 24 HRS. AFTER SHOT _____

GAS _____ CU. FT.

DRY HOLE _____

ABANDONED _____

DATE

AUG 22 1928 192

S. J. LEWIS

SCOUT

