DX 78-1


Summer

KANSAS

Section 35 Township 30 Range 2W

Well No. #6 Frantz

Company Anderson-Prichard

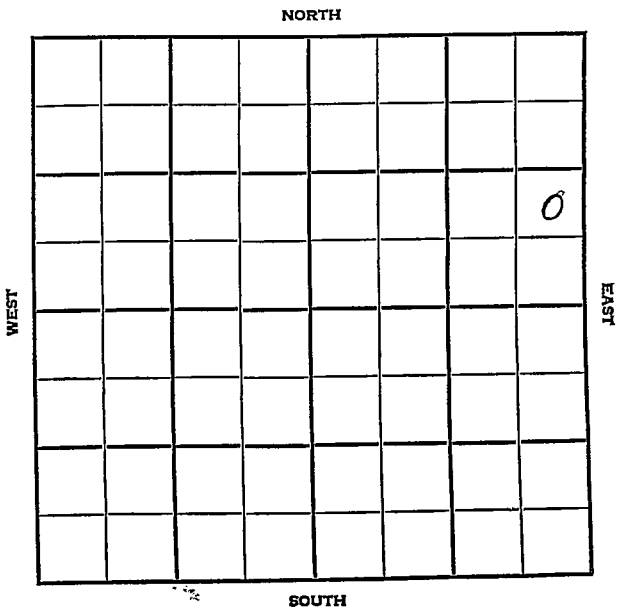

FORM 513 SUNRAY Sumner Co.

County ~~Sedgwick~~ Sumner Co. Elev.

Sec. 35 Twp. 30 Rge. 2W

Company Anderson-Prichard

Farm Name Frantz No. 6


TOPS	DEPTH	LOG	DATUM
Anh.			
Tp.			
H.			
Tr.			
Dg.			
Bl.			
L.			
K.C.			
B.K.C.			
Ce.			
C.			
M.			
M.			
K.			
Mz.			
Mo.			
V.			
S.			
S.			
A			
R.			
Pe.			
G.			
T.D.			

Loc. in Sec. NE SE NE

Geol.

Contr. Peel

Pool Anson

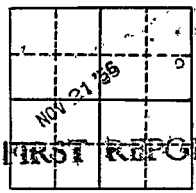

Date Comm. M I R

Co. Lse. No. Sec. T. R.

CORRECTION

FORM 513 SUNRAY

County Sumner Elev. 1321

Sec. 35 Twp. 30 Rge. 2W

Company Anderson-Prichard

Farm Name Frantz No. 6

TOPS	DEPTH	LOG	DATUM
Anh.			
T.P.			
H.			
Tr.			
Dg.			
Bl.			
L.			
K.C.	3085	3088	
B.K.C.		3321	
Ce.			
C.			
M. erro.	3737	3737	
M.		3752	
K.			
Mz.			
Mo.			
V.			
S.			
S.			
A			
R.			
P€.			
G.			
T.D.	3837		

Loc. in Sec. NE SE NE

Geol.

Contr. Peel

Lse.

Pool Anson

DEC 26 '56

C

COMPLETE

Co. No. Sec. T. R.

Date Comm.

M I R NOV 28 '56 11-21-56 8 7/8 647

1400 ✓ 2225 DEC 1 '56 5½ 3836/250

DEC 12 '56 CO 20/3777-82 TST

760 + 8 Bwph 4 hrs MA TST

2 B0 + 1½ Bwph Frac P. 109

B0 + 156 BW 22 hrs DEC 19 '56

DEC 26 '56 P. 54 B0 + 80 BW

24 hrs