KANSAS


Summer

SECTION 35 TOWNSHIP 30 RANGE 2W

WELL NO. #8 Frantz

COMPANY Anderson-Prichard

NORTH NW SE NE

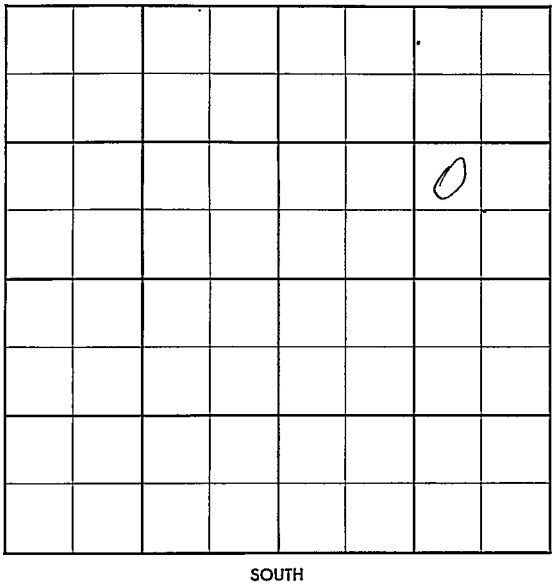

FORM 504-3 SUNRAY

FORM 513 SUNRAY

County Sumner Elev.

Sec. 35 Twp. 30 Rge. 2W

Company Anderson-Prichard

Farm Name Frantz No. 8

TOPS	DEPTH	LOG	DATUM
Anh.			
T.P.			
H.			
Tr.			
Dg.			
B.L.			
L.			
K.C.			
B.K.C.			
Ce.			
C.			
M.			
M.			
K.			
Mz.			
Mo.			
V.			
S.			
S.			
A			
R.			
P€.			
G.			
T.D.			

Loc. in Sec.

NW SE NE

1700' NL

990' EL

Geol.

Contr.

Glenn Peel

Pool

Anson

FEB 6 '57

0

FIRST REPORT

Date Comm.

M I R

Co. Lse. No. Sec. T. R.

FORM 513 SUNRAY

County Sumner Elev. 1337 KB

Sec. 35 Twp. 30 Rge. 2W

Company Anderson-Prichard

Farm Name Frantz No. 8

TOPS	DEPTH	LOG	DATUM
Anh.			
Tp.			
H.			
Tr.			
Dg.			
Bl.			
L.	3090		
K.C.			
B.K.C.	3326		
Ce.			
C.			
M.			
M.			
K.			
Mz.			
Mo.			
V.			
S.			
S.			
A			
R.			
Pe.			
G.			
T.D.	3345		

Loc. in Sec. NW SE NE

1700' NL

990' EL

Geol.

Contr. Glenn Peel

Lse. #3

Pool Anson

MAR 27 '57

COMPLETE

No.

Sec.

T.

R.

Date Comm.

M T R FEB 19 '57 2-7-57 8 5/8 @ 453/325

TD 1573 FEB 20 '57 EL. 1337 KB

Lsg 3090 DST 3324-45 op 1hr rec 2' oil BHP 0 RTD

3345 5 1/2 @ 3344 WOCT

FEB 27 '57 X CO 3300 28/3278-85

1/2 $ 1,4 Bot 1,4 Bwph 6 hrs

PB 3260 20/3227-32 tst 6

Gwph + Tr. oil 3 hrs 1/2 $

FORM 513-1 SUNRAY

41 BO + 12 BW in 14 hrs 12
& 6 BFph gep. 40% wtr
tstg hours 5 PD Pop P. 30 BO
3% wt 6 hrs MAR 16 '77 MAR 25
MAR 27 '77 P. 50 Bopd + 30 %
wtr

35-30-2 nw se ne