



Section 35 Township 30 Range 2W
Well No. #6 Renner
Company Falcon-Seaboard

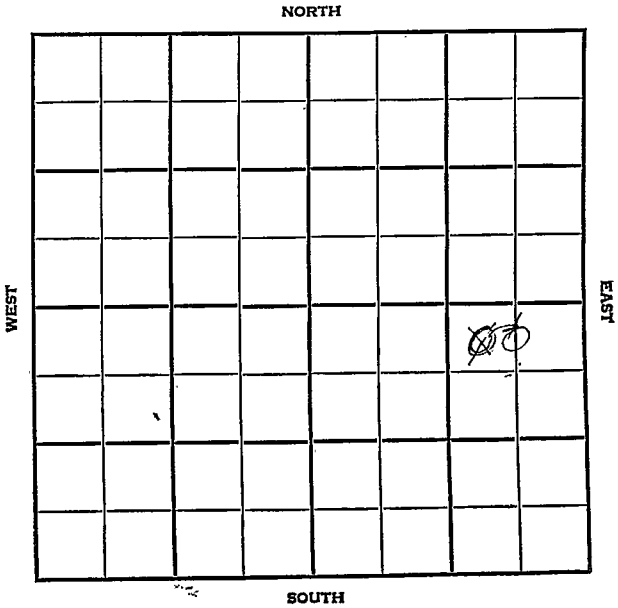

Summer		KANSAS	
SEC.	TWP.	R.	
35	30	2W	

WELL NO.	#4 Renner	FARM
COMPANY	Falcon Seaboard	
CONTRACTOR		

Anson	
_____ FT. FROM N. LINE	
_____ FT. FROM S. LINE	
_____ FT. FROM E. LINE	
_____ FT. FROM W. LINE	

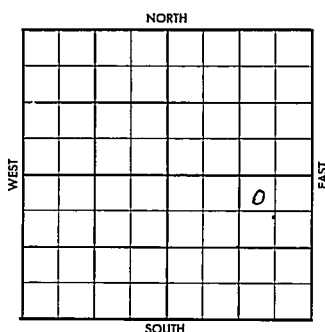

~~NW NE SE~~
NE SW SE

1956	ELEVATION	REPORT
------	-----------	--------

8-15 Comm. 8-9-56
9!! @ 535 w/527
Drlg. 2200'

County Sumner Elev. _____
 Sec. 35 Twp. 30 Rge. 2W
 Company Falcon-Seaboard
 Farm Name Benner No. 6

TOPS	DEPTH	LOG	DATUM
Anh.			
Tr.			
H.			
Tr.			
Dg.			
BL.			
L.			
K.C.			
B.K.C.			
Ce.			
C.			
M.			
M.			
K.			
Mz.			
Mq.			
V.			
S.			
S.			
A.			
R.			
Pe.			
G.			
T.D.			

Loc. in Sec. _____

NW NE SE

Geol. _____

Contr. _____

Co. tools _____

Pool _____

Anson

FIRST REPORT

DEC 5 '56

Date Comm. 12-3-5610" @ 560 WOC

CORRECTION

FORM 513 SUNRAY

Co.

County Sumner Elev. 1339
 Sec. 35 Twp. 30 Rge. 2W
 Company Falcon-Seaboard
 Farm Name Renner No. 6

TOPS	DEPTH	LOG	DATUM
Anb.			
TP.			
H.			
Tr.			
Dg.			
Bl.			
L.			
K.C.	<u>3095</u>		
BXC.			
Ce.			
C.			
M.	<u>erro</u> <u>3754</u>		
M.	<u>3760</u>		
K.			
Mz.			
Ma.			
V.			
S.			
S.			
A.			
R.			
Pe.			
G.			
TD.	<u>3876</u>		

Loc. in Sec.

NW NE SE

CNL

Geol.

Contr.

Co. tools

Pool

Anson

COMPLETE

NO

FEB 6 '57

Sec.

No.

Sec.

T.

R.

Date Comm. 12-3-56

10" @ 560 WOC DEC 12 '56 2915

DEC 19 '56 DST 3215-60 1hr 300'

oil + 360' VH 08' GCM + 6' ME'W

BHP. ? 3797 DEC 26 '56

5 1/2 3876 JAN 2 '57 WOC T JAN 9 '57 64'

3769-85 Flwd 55 Bbl

no/w 5 hrs 5.1. JAN 23 '57 JAN 30 '57 ✓

FEB 6 '57 X Pop. comp. P. 25 Bopd

no/w TE MISS PF 3769-85 RTD 3876