


Section 35 Township 30 Range 38WWell No. #1 SughrueCompany Hugoton Prod.

NORTH

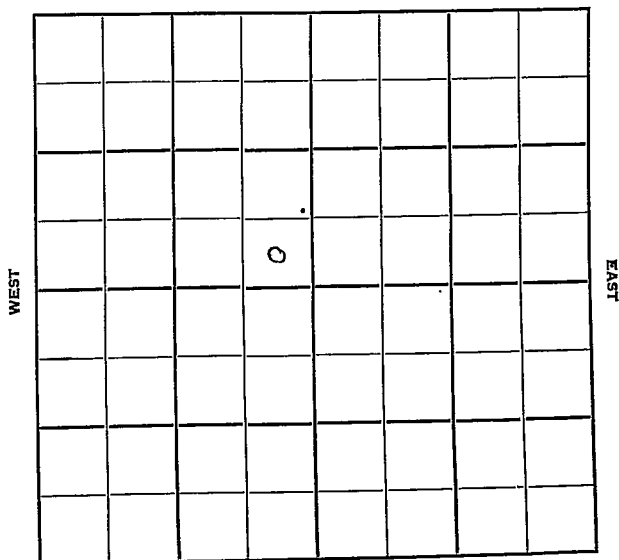

SOUTH

Grant KANSAS ✓

Sec. 35 Twp. 30 R. 38 W

Well No. # 1 Sughrue Farm

Hugoton Prod. Company


Burris Contractor

2440 Ft. from N. Line

Ft. from S. Line

Ft. from E. Line

2440 Ft. from W. Line

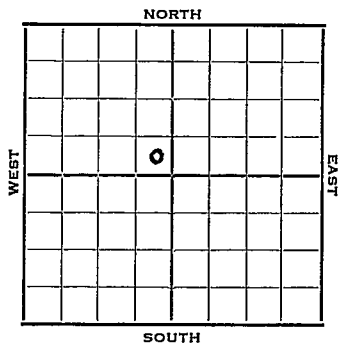

SE NW

1952 Elev. 3143' REPORT

4/16 Location

4/23 10" @ 507 WOC

4/30 RTD 2465' 7" @ 2454' WOC

5/7 TD 2700' 260' of 5" liner

5/14 3NR

5/21 Hol 2413 Her 2457

Krider 2475 Winfield 2547

Up Ft 2610 Low Ft 2652

5/28 NR

6/11 "

6/18 "

6/25 "

7/2 3,000 A

7/9 NR

7/17 18,000 A

7/23 Spud 4-18-52 Gas Well TD 2700
10" @ 507' Hol. 2413 Her. 2457

Kri. 2475 Win. 2547


Ft. Riley 2610

7" @ 2454' TD 2700 18000 A

Comp. 32,912,000 gas 390#

COMPLETED

County Grant State Kansas
 Sec. 35 (Blk. 30) (Sur. 38W) Map No. 1820
 Operator Hugoton Prod.
 Well No. 1 Farm Sughrue
 Elev. 3143 Location SE NW

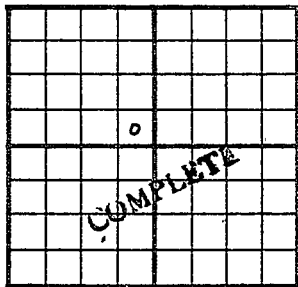

2440 Ft. From N Line NW
 2440 Ft. From W Line Quarter

Ist. Report

Completion JUL 23 1952

Remarks

Burris - Contr.

Spudding Date 4-18-52

Drilg. Data Gas well TD 2700

10" @ 507 Hol. 2413 Her. 2457

Kri. 2475 Win. 2547 Ft. Riley 2610

7" @ 2454 TD 2700 18000 A

Compl 32,912,000 gas 390#

J. G. McGEHEE