


Kiowa

KANSAS

SECTION 36 TOWNSHIP 30S RANGE 16W

WELL NO. #1 Walker

COMPANY Honaker-Davis Drlg.

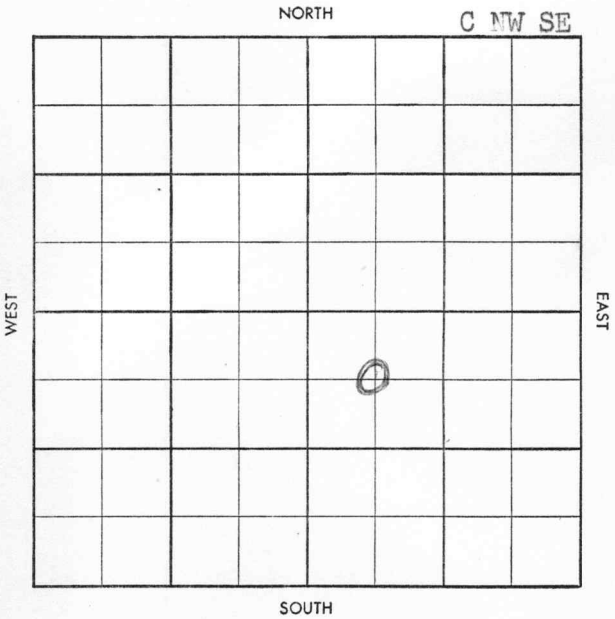

Top N Pool N

~~Shallow~~ Facet 25

WILDCAT

S-513-B

County Kiowa Elev. _____
 Sec. 36 Twp. 30 Rge. 16W
 Company Honaker-Davis Drlg.
 Farm Name Walker No. 1

TOPS	DEPTH	LOG	DATUM
Anh.			
Tp.			
H.			
Tr.			
Dg.			
B.L.			
L.			
K.C.			
B.K.C.			
Ce.			
C.			
M.			
M.			
K.			
Mz.			
Mq.			
V.			
S.			
S.			
A.			
R.			
Pf.			
G.			
T.D.			

Loc. in Sec. _____
C NW SE

 Geol. _____
 Contr. _____
 Co. Tools # 4
 Pool _____
Wildcat



Date Comm. 3/17/58 (Gulf - DHM)
 Drlg. 1020 - no surf yet.

Co.
Lse.
No.
Sec.
T.
R.

Twp. X Pool X

Co. X Facet X

CORRECTION

5-513-B

County Kiowa Elev. 1941 OF 1745 NB
 Sec. 36 Twp. 30 Rge. 16W
 Company Honaker-Davis Drlg. Shell & Interoil
 Farm Name Walker No. 1

TOPS	DEPTH	LOG	DATUM
Anh.			
Tp.			
H.	<u>3915</u>	<u>3916</u>	
Tr.			
Dg.			
B.L.	<u>4094</u>	<u>4094</u>	
L.	<u>4109</u>	<u>4108</u>	
K.C.			
B.K.C.			
Ce.			
C.		<u>4630</u>	
M.	<u>PBC 4655?</u>	<u>4664</u>	
M.		<u>4684</u>	
K.			
Mz.			
Mq.			
V.	<u>4724</u>	<u>4720</u>	
S.		<u>4914</u>	
S.			
A.		<u>4978</u>	
R.			
Pf.			
G.			
T.D.	<u>500 B</u>		

Loc. in Sec. C NW SE
 Geol. _____
 Contr. _____
 Co. Tools # 4
 Pool G.R.W.
Wildcat

COMPLETE

MAY 21 '58

Date Comm. 3/17/58 (Gulf - DMM)
 Drlg. 1020 - no surf yet. 8" 400/300

Ø 2720 Ø 4460
DST 4732 - 47 Ø 60" g/13" ga
734 mud/15 119-mud/60" 330°
40° ga oil FP 165-120 BHP
1730 - 1520/20" DST 4747-75
Ø 3/4 hr 30' M FP 12-40 BHP
70-70 DST 4797-4811 (SD)
Ø 1 hr 110' 5 ga SW 140' SW
FP 55-345 BHP 1750-1625

Co.
 Loc.
 No.
 Sec.
 T.
 R.