

Section 36 Township 30 **KANSAS**
Range 15 W

Well No. # 1 Hoagland

Company Great Lakes Carbon

NORTH

			0				

WEST

EAST

SOUTH

Barber

KANSAS ✓

Sec. 36 Twp. 30 R. 15W

Well No. #1 Hoagland Farm

Great Lakes Carbon Company

Semi Wildcat Contractor


_____ Ft. from N. Line

467 Ft. from S. Line

467 Ft. from E. Line

_____ Ft. from W. Line

SE SE NW

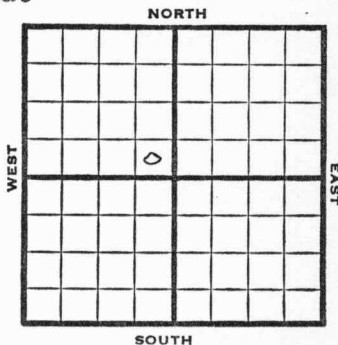

1952 Elev. 1760' REPORT

7/30 Spud 7-28-52
Location

8/6 Anhy 625 8" @ 809
Drlg. 2685

8/13 Lost circu. @ 3162'

8/20 DST in Topeka 3098-3162 3/4 hr. 50'
M O# Drlg.

8/26 DST 4166-86, 1 hr. 96' m 1350#
Drlg. 4196'

9/3 Heeb. 3707 Lans. 3887
BKC 4258 TD 4428

9/10 Spud 7-28-52
D&A TD 4428'
Anhy 625' 8" @ 809'
DST in Top. 3098-3162
open 3/4 hr. rec. 50' mud 225#
DST 4166-86 open 1 hr. rec. 96' mud
1350# Heeb. 3707 Lans. 3887
B KC 4258 Mass Z 4322
TD 4428 D&A

ABANDONED

