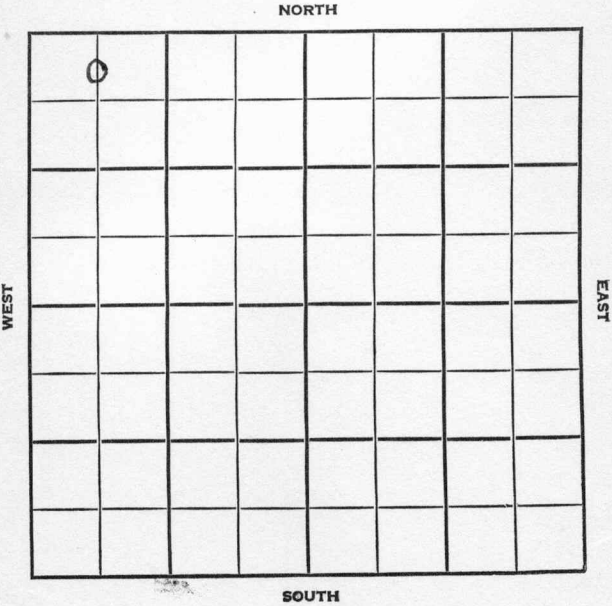


Section 36 Township 30 Range 9 W

Well No. # 1 Swingle "A"

Company Pickrell Drlg.



Kingman

KANSAS

SEC.	TWP.	R.
36	30	9W

WELL NO.

#1 Swingle "A"

FARM

COMPANY

Pickrell Drlg.

CONTRACTOR

Co. Tools.

Wildcat.

330

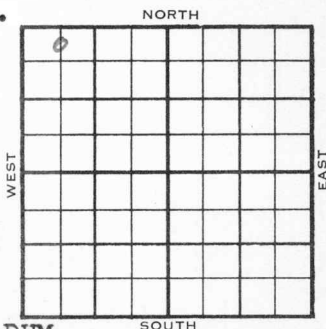
Ft. from N. Line

Ft. from S. Line

Ft. from E. Line

660

Ft. from W. Line

C N $\frac{1}{2}$ NW NW

Magnolia F/O CSO- AC & DHM

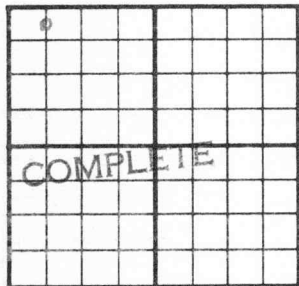
	ELEVATION	REPORT
1955	1601'	

1/5 M I M

2/23 Spud 1-4-55 SI Gas well TD 4425
 8" @ 120 Heeb 3355 Doug 3390
 Doug sd. 3428 Lans 3563 Miss 4307
 DST 4309-23, open 1 hr gas in 25 min
 100,000 CFG, rec 32' GCM 1720#
 DST 4323-43 open 1 hr gas in 58 min
 rec 165' GCM 1480# TD 4419 5" @
 4419' CO to 4425 60/4314-29
 frac. 840,000 CFG SI 45 min
 1,900,000 CFG 1,140,000 CFG 3 $\frac{1}{2}$ hr.
 Comp. SI gas well 1,450,000 CFGPD

COMPLETED

FABEN GILSTRAP

County Kingman State KansasSec. 36 (Blk. 30) (Sur. 9W) (Twp.) (Rge.) Map No.Operator Pickrell Drlg.Well No. 1 Farm Swingle "A"Elev. 1601 Location C N $\frac{1}{2}$ NW NW330 Ft. From N Line NW660 Ft. From W Line Quarter

1st. Report

Completion FEB 23 1955Remarks WildcatCo. toolsSpudding Date 1-4-55Drlg. Data SI Gas well TD 44258" @ 120 Heeb. 3355 Doug. 3390Doug. sd. 3428 Lans. 3563 Miss. 4307DST 4309-23 open 1 hr. gas in 25 min.100,000 cfg Rec. 32' gcm 1720#DST 4323-43 open 1 hr. gas in 58 min.Rec. 165' gcm 1480# TD 4419 5" @4419 CO to 4425 60/ 4314-29 frac840,000 cfg SI 45 min. 1,900,000 cfg1,140,000 cfg : 3 $\frac{1}{2}$ hr.Comp. SI gas well 1,450,000 cfgpd

FABEN GILSTRAP