

KANSAS

Section 36 Township 30 Range 11 W
Well No. # 1 Mease "A"
Company Schafer Drlg.

WEST

EAST

SOUTH

Barber

KANSAS

SEC.	TWP.	R.
36	30	11W

WELL NO.

#1 Mease "A"

FARM

COMPANY

Schafer Drlg.

CONTRACTOR

Co. Tools.

Wildcat.

330


Ft. from N. Line

Ft. from S. Line

330

Ft. from E. Line

Ft. from W. Line

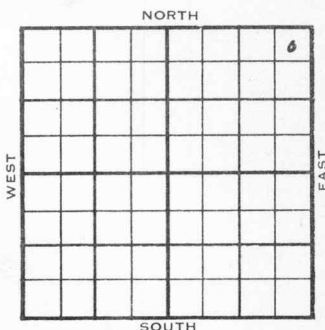

NE NE NE

Atl. & Skelly - DHM

	ELEVATION	REPORT
1955	1749'	

1/12

Spud 1-8-55

8" @ 243'

Drlg. 1380'

2/2

Spud 1-8-55 D & A TD 4907

8" @ 243 Doug. 3790

DST 3790-3800 open $\frac{1}{2}$ hr rec 750' SW

1375# Lans 3825 Miss 4426

DST 4416-30 open 1 hr rec 20' mud O#

DST 4427-40 open $\frac{1}{2}$ hr rec 20' mud. O#

Kh. 4510', Viola 4675', Simp. 4761

DST 4751-67 open 1 hr rec 270' MW

1960#. Arb. 4877 TD 4907'

D & A

ABANDONED

County **Barber** State **Kansas**Sec. **36** (Blk.) **30** (Sur.) **11w** Map No.
(Twp.) (Rge.)Operator **Schafer Drlg.**Well No. **1** Farm **Mease "A"**Elev. Location **NE NE NE**

330 Ft. From **N** Line **NE****330** Ft. From **E** Line Quarter1st. Report **JAN 1 2 1955**

Completion

Remarks **Atl. & Skelly - DFM****Co. tools**Spudding Date **1-8-55**Drlg. Data **Wildcat****8" @ 243 drlg. 1380**

FABEN GILSTRAP

County Barber State Kansas
 Sec. 36 (Blk.) 30 (Sur.) 11W Map No.
 Operator Schafer Drlg.
 Well No. 1 Farm Mease "A"
 Elev. 1749 Location NE NE NE



330 Ft. From N Line NE
330 Ft. From E Line Quarter

1st. Report

Completion FEB 2 1955

Remarks Wildcat

Co. tools

Spudding Date 1-8-55

Drlg. Data D & A TD 4907

8" @ 243 Doug. 3790 DST 3790-3800

open $\frac{1}{2}$ hr. Rec. 750' sw 1375#

Lans. 3825 Miss. 4426 DST 4416-30

open 1 hr. Rec. 20' mud 0#

DST 4427-40 open $\frac{1}{2}$ hr. Rec. 20' mud

0# Kh. 4510 Viola 4675 Simp. 4761

DST 4751-67 open 1 hr. Rec. 270' mw

1960# Arb. 4877 TD 4907

D & A

FABEN GILSTRAP