FORM 51 10M 7-48 PETROL


KANSAS Grant

Section 36 Township 30 Range 36W

Well No. 1 Guy Fairchild

Company Magnolia

Hugoton Pool

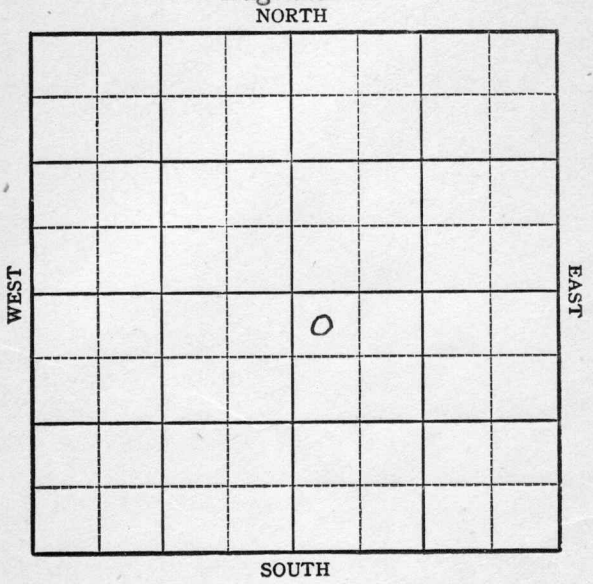

FORM 252-A
5M 4-48 PETROL

KANSAS Grant

Sec. 36 Twp. 30 R. 36W

Well No. 1 Guy Fairchild Farm

Magnolia Company

Hugoton Pool


330 Ft. from N. Line

_____ Ft. from S. Line

_____ Ft. from E. Line

330 Ft. from W. Line

NW SE

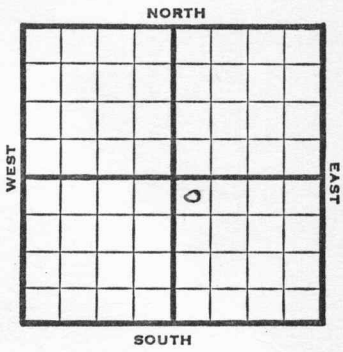

1948	Eli 2992' REPORT
9/22	10" @ 680' Drilling 1890'
9/29	TD 2730' 7" @ 2729'
10/6	192 shots 2640-86 - 7000 acid 120 " 2587-2614 " " 144 " 2542-72 " "
10/13	"
10/20	TD 2730' 7"@ 2729' Perf 21000 acid 10,900,000 Gas 397# R PR. Comp COMPLETED

Form 27—100 Bks.—4-48—Petrol

Grant County ~~Kansas~~ State

Map No. Sec. 36 Twp. 30 R. 36W


Well No. 1 Guy Fairchild

Magnolia Company

FIRST REPORT Contractor

NW SE

SECTION PLAT

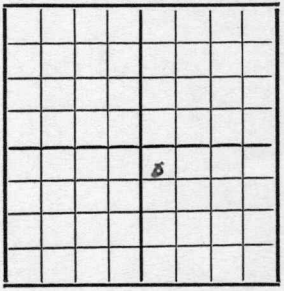

330 Ft. from N. Line

Ft. from S. Line

Ft. from E. Line

330 Ft. from W. Line

Hugoton Pool

Remarks:

10" @ 680 drlg. 1890

Date SEP 2 2 1948 Scout S. J. LEWIS

Form 26 200 Bks. 9-48 Petrol

Kansas

Hugoton Pool

Map No. _____ Sec. 36 Twp. 30 R. 36W

Well No. 1 Guy Fairchild


Magnolia Company

COMPLETE Contractor

NW SE

E 12992

SECTION PLAT

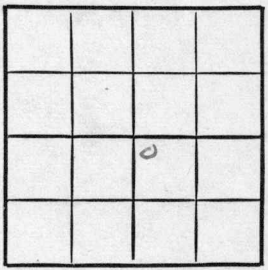

330 Ft. from N. Line

_____ Ft. from S. Line

_____ Ft. from E. Line

330 Ft. from W. Line

Grant County

Location _____

Rig up _____

Drilling and Remarks:

TD 2780

7" @ 2729

Out 2100 acid

10,900,000 Gas

897# R/P

RECORD

Cased _____ in., _____ ft.

Sand _____

Gas _____

Oil _____

Total Depth 2780

PRODUCTION

1st 24 hrs. Nat. _____

1st 24 hrs. after shot _____

Gas _____ Cu. Ft.

Dry Hole _____

Abandoned _____

Date

OCT 20 1948 19 S. J. LEWIS Scout