


Haskell KANSAS

DX 78-1

Section 36 Township 30 Range 32W

Well No. 1 Bird "A"

Company Cities Service \*

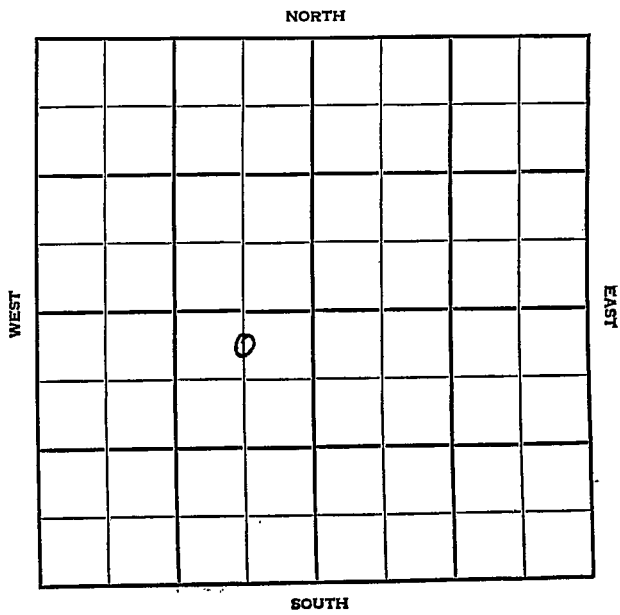

# Haskell KANSAS


SEC. 36	TWP. 30	R. 32W ✓
---------	---------	----------

WELL NO. 1 Bird "A" FARM

COMPANY Cities Service

CONTRACTOR \_\_\_\_\_

100 \_\_\_\_\_ Ft. from N. Line  
 \_\_\_\_\_ Ft. from S. Line  
600 \_\_\_\_\_ Ft. from E. Line  
 \_\_\_\_\_ Ft. from W. Line

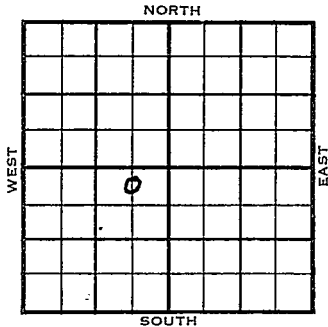

C N $\frac{1}{2}$  NE SW

DATE	ELEVATION	REPORT
1954	2838'	
6/30		Spudding 6-24-54 8" @ 61 4 WOC
7/7		Herr 2576 up Kr 2598 Low Kr 2624 Win 2675 TD 2720 5" @ 2719
7/21		Spud 6-24-54 - Gas Well TD 2720' 8" @ 614' Her. 2576', Kri 2598', Win 2675' TD 2720' 5" @ 2719' CO to 270' 80/2630-46, 20/2622-26, 80/2600-16 1000A Dol-frac Comp. 10,700,000 cfigpd 427#

**COMPLETED**



County Haskell State Kansas

Sec. 36 (Blk. 30) (Sur. 32W) (Twp.) (Rge.) Map No.

Operator Cities Service

Well No. 1 Farm Bird "A"

Elev. 2838 Location C N $\frac{1}{2}$  NE SW

COMPLETE					

100 Ft. From N Line SW

600 Ft. From E Line Quarter

1st. Report \_\_\_\_\_

Completion JUL 21 1954

Remarks \_\_\_\_\_

Spudding Date 6-24-54

Drlg. Data Gas well TD 2720

8" @ 614 Her. 2576 Kri. 2598

Win. 2675 TD 2720 5" @ 2719

CO to 2720 80/ 2630-46 20/ 2622-26

80/ 2600-16 1000 A Dol-frac

Comp. 10,700,000 c/gpd 427#