

Section 36 Township 30 Range 2WWell No. #1 RinerCompany Anderson-Prichard

NORTH

0							

WEST

EAST

SOUTH

Summer

Sec. 36 Twp. 30 R. 2W

Well No. #1 Riner Farm

Anderson-Prichard Company

Contractor


430' Ft. from N. Line

Ft. from S. Line

Ft. from E. Line

330' Ft. from W. Line

NW NW NW (Twin Well)

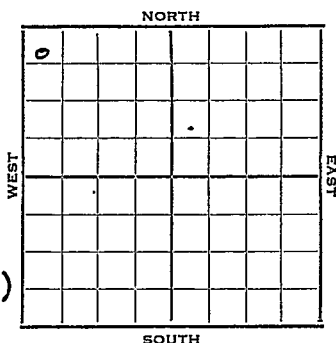

1952 Elev. 1334' REPORT

3/26 Location
4/1 "
4/9 8" @ 447' WOC
4/23 Lans. 2083
DST 3212-18
4/30 DST 3212-18' 1 hr, 2870' gas, 360'
O & GCM, 360' OCW, 360' wtr. 1070#
FP 400#
DST 3266-71, 1 hr, 3060' gas, 270'
O & GCM, 30' free oil 1185#
Miss 3739'
DST 3742-49 1 hr, 30' M 1215#
Drlg. 3800'
5/7 Warsaw 3754 DST 3174-86 in V. 1 hr.
600' SW 1500# TD 4214
5/14 5" @ 3859' DP 3801 24/ 3775-80
B/ 15 gal wph for 5 hrs. PB 3162
52/ 3743-50 SO, g & wtr. 1500 A
5/21 NR
5/28 Est 1 M gas 48/3750-56 2000 A
est 2 M gas 2 BFPB PB 3318
72/3264-76 1000 A S/100 BO & 25%
wtr 12 hrs. POP
6/4 Spud 4-5-52 Oil Well TD 4214'
8" @ 447 Lans. 3083 DST 3212-18
open 1 h. rec. 2870' gas 360' O&GCM

OVER

1952

6/4 360' ocw 360' wtr. DST 3266-71
open 1 hr. rec. 3060' gas 270' O&GCM
30' free oil Miss. 3739
DST 3742-49 open 1 hr. rec. 30' mud
Warsaw 3754 DST 3174-86 open 1 hr.
rec. 600' sw TD 4214' 5" @ 3859
CO to 3801 24/ 3775-80 B/ 15 gwph
FB 3762 52/ 3743-50 SO & G & W
1500 A 1 mcfg. 48/ 3750-56 2000 A
2 mcfg 2 bfph FB 3318 72/ 3264-76
1000 A S/ 100 bo 25% wtr.
Comp. 50 bopd 25% wtr.

COMPLETED

County Sumner State Kansas
 Sec. 36 (Blk.) 30 (Sur.) 2W Map No.
 (Twp.)
 Operator Anderson - Prichard
 Well No. 1 Farm Riner
 Elev. Location NW NW NW (twin well)

0							

FIRST REPORT

430 Ft. From N Line NW
330 Ft. From N Line Quarter
 1st. Report MAR 26 1952

Completion

Remarks

Spudding Date

Drlg. Data

Location


J. G. McGEHEE

Scout Cards
Land Small Map
Land Wall Map
Tracings
France Map
Pierce Map
Misc.

28 1952

Drig. Data

County Sumner State Kansas
 Sec. 36 (Blk.) 30 (Sur.) 2W Map No.
 Operator Anderson-Prichard
 Well No. 1 Farm Riner
 Elev. 1334 Location NW NW NW (twin well)

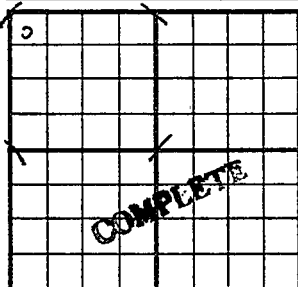

430 Ft. From N Line NW
330 Ft. From W Line Quarter
 1st. Report
 Completion JUN 4 1952
 Remarks

Spudding Date 4-5-52

Drlg. Data Oil well TD 4214

8" @ 447 Lans. 3083 DST 3212-18

open 1 hr. Rec. 2870' gas 360' o & gcm
360' ocw 360' water DST 3266-71

open 1 hr. Rec. 3060' gas 270' o & gcm
30' free oil Miss. 3739 DST 3742-49

open 1 hr. Rec. 30' mud Warsaw 3754

DST 3174-86 open 1 hr. Rec. 600' sw

TD 4214 5" @ 3859 CO to 3801 24/ 3775-

80 B/ 15 gwph PB 3762 52/ 3743-50

SO & G & W 1500 A 1 mcf/g 48/ 3750-56

2000 A 2 mcf/g 2 bfph PB 3318

72/ 3264-76 1000 A S/ 100 bo 25% water

Comp. 50 bopd 25% water

J. G. McGEHEE

Scout Cards

Land Small Map

Land Wall Map

Tracings

France Map

Peace Map

Misc.

JUN 11 1952

Orig. Data