


Section 36 Township 36 Range 2W● Well No. #2 RinerCompany Anderson-Prichard

NORTH

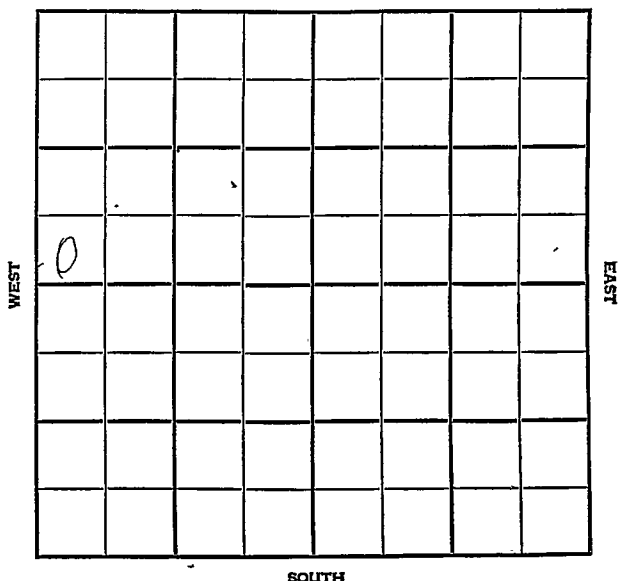

County Sumner Elev. 1331
 Sec. 36 Twp. 30 Rge. 2W
 Company Anderson-Prichard
 Farm Name Riner No. 2

TOPS	DEPTH	LOG	DATUM	Loc. in Sec.
Anb.				SW SW NW
TP.				
H.				
Tr.				
Dg.				
BL.				
L.				Geol.
K.C.				Contr.
B.K.C.				Peel Bros.
Ce.				Pool
C.				Anson
M.				
M.				
K.				
Mz.				
Mo.				
V.				
S.				
S.				
A.				
R.				
PE.				
G.				
T.D.				

FIRST REPORT

OCT 31 1956

Date Comm. 10-24-56
8" @ 154/300 drlg. 2440

V. 11

E. 11

21 8

Co.

Use.

No.

Sec.

T.

R.

County Sumner Elev. 1331
 Sec. 36 Twp. 30 Rgs. 2W
 Company Anderson-Prichard
 Farm Name Riner No. 2

TOPS	DEPTH	LOG	DATUM	Loc. in Sec.
Anb.				SW SW NW
Tr.				
H.				
Tr.				
Dg.				
BL.				
L.				Geol.
K.C.	3092			Contr.
B.K.C.				Peel Bros.
Ce.				Pool
C.				Anson
M. <u>CRP.</u>	3741			
M.	3750			
K.				
Mz.				
Mo.				
V.				
S.				
S.				
A.				
R.				
Pe.				
G.				
T.D.	3840			

Date Comm. 10-24-56
8" @ 454/300 drlg. 2440 NOV 7 '56
DST 3213-28 1hr. 90' 05' 6CM
BHP 200/20 DST 3269-3287
1hr. 60' 50' 86CM BHP 300/20
5 1/2 @ 3839/250 NOV 13 '56 CO 40/3768
-78 10 CF 3090 wth 1hr
11 8 B0 + 11 BW 6 hrs Frac
5x8 8 77 B0 + 65 BW in 17 hrs
T&P NOV 21 '56 P. 27 B0 790 wth
17 hrs. NOV 28 '56

FORM 513-1 SUNRAY

P 71 Bopd 4098 wto.

36-30-2

sw sw sw