

STATE CORPORATION COMMISSION OF KANSAS
OIL & GAS CONSERVATION DIVISION
WELL COMPLETION OR RECOMPLETION FORM
ACO-1 WELL HISTORY
DESCRIPTION OF WELL AND LEASE

Operator: License # 5398
Name ARCO OIL AND GAS COMPANY
Address Box 1610
City/State/Zip Midland, Texas 79702

Purchaser Northern Natural Gas Company

Operator Contact Person Ken W. Gosnell
Phone 915/688-5672

Contractor: License # 03098
Name Exeter

Wellsite Geologist
Phone

Designate Type of Completion

☒ New Well ☐ Re-Entry ☐ Workover

☒ Oil ☐ SWD ☐ Temp Abd
☒ Gas ☐ Inj ☐ Delayed Comp.
☐ Dry ☐ Other (Core, Water Supply etc.)

If ONWO: old well info as follows:

Operator
Well Name
Comp. Date Old Total Depth

WELL HISTORY

Drilling Method:

☒ Mud Rotary ☐ Air Rotary ☐ Cable

7-19-88 7-21-88 8-8-88
Spud Date Date Reached TD Completion Date

2800 2752
Total Depth PBTD

Amount of Surface Pipe Set and Cemented at 787 feet
Multiple Stage Cementing Collar Used? ☐ Yes ☒ No
If yes, show depth set feet
If alternate 2 completion, cement circulated
from feet depth to w/ SX cmt
Cement Company Name
Invoice #

API NO. 15-067-20794

County Grant

NE SW NW Sec 3 Twp 30 Rge 38 East
X West

3843 Ft North from Southeast Corner of Section
3998 Ft West from Southeast Corner of Section

(Note: Locate well in section plat below)


Lease Name Clyde Ball Unit Well # 3

Field Name Hugoton

Producing Formation Chase

Elevation: Ground 3120 KB 3130

Section Plat

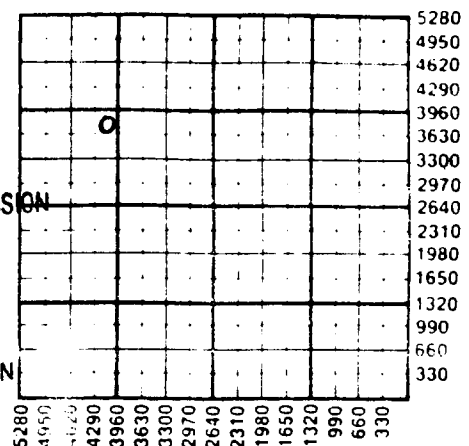

RECEIVED

NOV 17 1988

CONSERVATION DIVISION

Wichita, Kansas

WATER SUPPLY INFORMATION

Disposition of Produced Water:

Disposal

Docket #

Repressuring

Questions on this portion of the ACO-1 call:

Water Resources Board (913) 296-3717

Source of Water:

Division of Water Resources Permit # 88-352

☒ Groundwater 3863 Ft North from Southeast Corner
(Well) 4113 Ft West from Southeast Corner of
Sec 3 Twp 30 Rge 38 East X West

Surface Water Ft North from Southeast Corner
(Stream, pond etc) Ft West from Southeast Corner
Sec Twp Rge East West

Other (explain)
(purchased from city, R.W.D. #)

INSTRUCTIONS: This form shall be completed in triplicate and filed with the Kansas Corporation Commission, 200 Colorado Derby Building, Wichita, Kansas 67202, within 120 days of the spud date of any well. Rule 82-3-130, 82-3-107 and 82-3-106 apply. Information on side two of this form will be held confidential for a period of 12 months if requested in writing and submitted with the form. See rule 82-3-107 for confidentiality in excess of 12 months. One copy of all wireline logs and drillers time log shall be attached with this form. Submit CP-4 form with all plugged wells. Submit CP-111 form with all temporarily abandoned wells.

All requirements of the statutes, rules and regulations promulgated to regulate the oil and gas industry have been fully complied with and the statements herein are complete and correct to the best of my knowledge.


Signature Ken W. Gosnell

Title Engr. Tech. Date 11-14-88

Subscribed and sworn to before me this 14 day of November 1988

Notary Public Lisa A. Gordy

Date Commission Expires 6-6-92

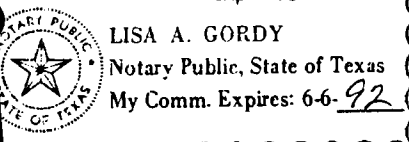

KANSAS GEOLOGICAL SURVEY
WICHITA BRANCH

NOV 17 1988

K.C.C. OFFICE USE ONLY

☒ Letter of Confidentiality Attached
☒ Wireline Log Received
☐ Drillers Time Log Received

Distribution

KCC SWD/Rep NGPA
☒ KGS Plug Other
(Specify)

Sec 3, Twp 30 Rge 38 W