


Have log

WELL RECORD

14-30-38W

(Mail to Kansas Geological Survey, 4150 Monroe Street, Wichita, Kansas 67209)

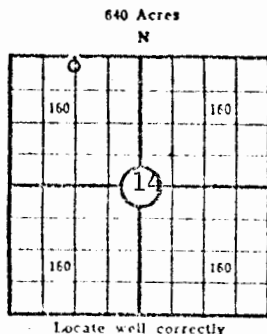

Lease Name: Baptist Fischer Well No. 2-14
 Well Located: 1320' fr WL and 200' fr NL
Grant Co., Kansas SEC 14 TWP 30S RGE 38W
 Operator: Mesa Petroleum Co.
 Address: P. O. Box 2009, Amarillo, Texas 79105
 Elevation: Ground 3128' D.F. ---- K.B. 3136'
 Type Well: (Oil, gas, dry hole) Gas

Drilling Commenced: 11-30 19 71 Drilling Completed: 12-5 19 71
 Well Completed: 12-19 19 71 Total Depth 2910'
 Initial Production: _____

Casing Record

Size: 8-5/8" Set at 579' Size: _____ Set at _____
 Size: 5-1/2" Set at 2906' Size: _____ Set at _____

Liner Record

Size: _____ Set from _____ To _____

Cementing

Casing Size	Sacks	Type Cement and Additives
<u>8-5/8"</u>	<u>500</u>	<u>common plus 3%cc</u>
<u>5-1/2"</u>	<u>300</u>	<u>Posmix, 18% salt, 12-1/2# Gilsonite/sx</u>
_____	_____	_____

Perforations

Formation	Perforated Interval and Number Shots
<u>Council Grove</u>	<u>2722-2859' (35') 4 holes/ft.</u>
_____	_____
_____	_____
_____	_____

Electric Log Run (Show type log and depths covered)

Radioactivity Log 2909-1700', 600'-surf.

Show Drill Stem Tests,
Well Stimulation and
Production Tests

14-30-38w

Formation Top Bottom

Herrington
Krider
Winfield
Fort Riley
L/Fort Riley
Wreford
Council Grove

2396
2412
2481
2541
2606
2692
2711

2412
2481
2541
2606
2692
2711
TD

Frac'd with 3000 bbls. water, 100,000#
river sand. Blow test after frac 4850MCF
(pitot tube).

1850,000
3136 KB

Surface Clay Sand 506
Red Bed 950
Red Bed, Sand, Anhydrite 1470
Red Bed & Shale 1705
Red Bed, Anhydrite, Shale 1910
Lime & Shale 2300
Lime 2910
R.T.D. 2910

LOG TOPS DEPTH

HER 2396
C GR 2710
TD 2910

