


WELL RECORD

Have log.

15-30-38W

(Mail to Kansas Geological Survey, 4150 Monroe Street, Wichita, Kansas 6720)

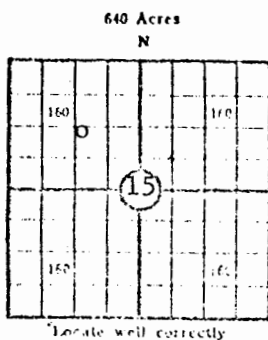

Lease Name: Scully Well No. 2-15
 Well Located: 1400' fr N & W Lns.
Grant Co., Kansas SEC 15 TWP 30S RGE 38W
 Operator: Mesa Petroleum Co.
 Address: P. O. Box 2009 Amarillo, Texas 79105
 Elevation: Ground 3144.9 D.F. ----- K.B. 3153'
 Type Well: (Oil, gas, dry hole) Gas

Drilling Commenced: 11-25 19 71 Drilling Completed: 11-29 19 71
 Well Completed: 12-15 19 71 Total Depth 2910'
 Initial Production: -----

Casing Record

Size: 8-5/8" Set at 591' Size: ----- Set at -----
 Size: 5-1/2" Set at 2908' Size: ----- Set at -----

Liner Record

Size: ----- Set from ----- To -----

Cementing

Casing Size	Sacks	Type Cement and Additives
<u>8-5/8"</u>	<u>500</u>	<u>common plus 3% cc</u>
<u>5-1/2"</u>	<u>300</u>	<u>Posmix, 18% salt, 12-1/2# Gilsonite/sx.</u>

Perforations

Formation Perforated Interval and Number Shots

Council Grove 2731-2893' (49') 4 holes/ft.

Electric Log Run (Show type log and depths covered)

Radioactivity Log 2905-1750' 600'-surface

(Fill in formation and related information on reverse side)

Show Drill Stem Tests,
Well Stimulation and
Production Tests

15-30-38w

Formation	Top	Bottom	
Herrington	2409	2430	Frac'd with 3000 bbls. water, 100,000# river sand. Blow test after frac 7000 MCF (pitot tube).
Krider	2430	2500	
Winfield	2500	2558	
Fort Riley	2558	2618	
L/Fort Riley	2618	2702	
Wreford	2702	2724	
Council Grove	2724	TD	

7000,000
3153KB

Surface Clay, Sand	592
Red Bed	1185
Red Bed & Sand	1685
Shale & Shells	1752
Anhydrite	1761
Shale & Shells	2028
Shale - Lime	2190
Shale & Lime	2340
Lime & Shale	2465
Lime	2910
R.T.D.	2910

LOG TOPS	DEPTH
HER	2409
C GR	2725
RTD	2910

