

# KANSAS


Meade

Section 4 Township 30 Range 30W

Well No. 1 Clancy

Company Northern Natural Gas

Hugoton

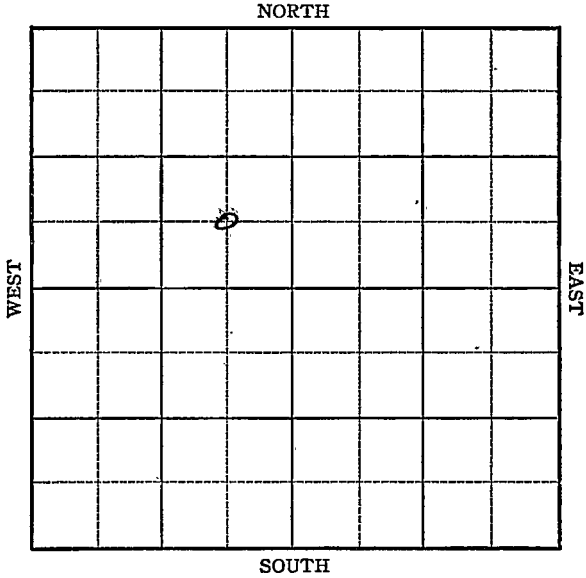

**KANSAS**

Maade

Sec. 4 Twp. 30 R. 30W ✓

Well No. #1 Clancy Farm

Northern Natural Gas

Company

Hugoton Pool (Moran, Cont.)

NORTH

\_\_\_\_\_ Ft. from N. Line

660'


\_\_\_\_\_ Ft. from S. Line

660'

\_\_\_\_\_ Ft. from E. Line

\_\_\_\_\_ Ft. from W. Line

C SE NW

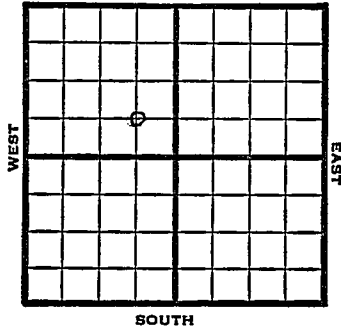

1949

Elev 2811'

REPORT

6/1 Deep test  
6/7 Location  
6/15 "  
6/21 RUR  
6/28 "  
7/6 16" @ 638'  
Drlg 2130'  
7/12 10" @ 2665'  
Drlg. 2815'  
7/20 "  
7/27 "  
8/3 TD 3225'  
8/10 Drlg. 5695'  
8/17 Miss 5790'  
TD 5893'  
8/24 " -  
8/31 "  
9/7 "  
9/14 TD 5893'  
Miss 5790'  
Aband.

**ABANDONED**

Kansas

Hugoton Pool

Map No. \_\_\_\_\_ Sec. 4 Twp. 30 R. 30WWell No. 1 Clancy

Northern Natural Gas Company

Moran Contractor

C SE NW

FIRST REPORT  
SECTION PLAT

\_\_\_\_\_ Ft. from N. Line

660 Ft. from S. Line660 Ft. from E. Line

\_\_\_\_\_ Ft. from W. Line

	o		

Meade County

Location \_\_\_\_\_

Rig up \_\_\_\_\_

Drilling and Remarks:

Deep test

## RECORD

Cased \_\_\_\_\_ in., \_\_\_\_\_ ft.

Sand \_\_\_\_\_

Gas \_\_\_\_\_

Oil \_\_\_\_\_

Total Depth \_\_\_\_\_

## PRODUCTION

1st 24 hrs. Nat. \_\_\_\_\_

1st 24 hrs. after shot \_\_\_\_\_

Gas \_\_\_\_\_ Cu. Ft.

Dry Hole \_\_\_\_\_

Abandoned \_\_\_\_\_

Date

JUN 1 1949 19

S. J. LEWIS

Scout

Map No. 1 Sec. 4 Twp. 30 R. 3 OW

Well No. 1 Clancy

Northern Natural Gas Company

**ABANDONED**

Contractor

C SE NW

*E 1,2871*

SECTION PLAT

         Ft. from N. Line

660 Ft. from S. Line

660 Ft. from E. Line

         Ft. from W. Line

	o		

Meade County

Location                                 

Rig up                                 

Drilling and Remarks:

*Misc 5790*

**RECORD**

Cased          in.,          ft.

Sand                                 

Gas                                 

Oil                                 

Total Depth 5893

**PRODUCTION**

1st 24 hrs. Nat.                         

1st 24 hrs. after shot                         

Gas                                  Cu. Ft.

Dry Hole                                 

Abandoned                                 

Date

SEP 14 1949

S. J. LEWIS Scout