

Kiowa

KANSAS

Section 4 Township 30 Range 16W

Well No. #1 Millar

Company Lewis Travis

NORTH

0							

WEST

EAST

SOUTH

Kiowa

KANSAS

Sec. 4 Twp. 30 R. 16W ✓

Well No. #1 Miller Farm

Lewis Travis Company

Contractor


Ft. from N. Line

330' Ft. from S. Line

Ft. from E. Line

330' Ft. from W. Line

SW SW NW

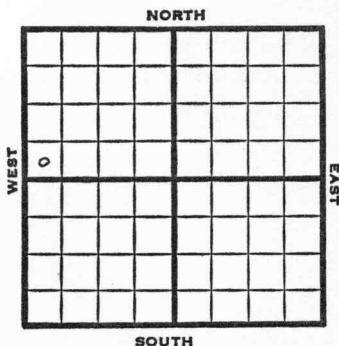

1951

Elev. 1850'

REPORT

5/9

Spud 5-6-61

8" @ 478

Drlg. 1400'

5/29

Spud 4-6-51

D&A TD 4973

8" @ 478 Heeb. 3787

Br Lime 3986 Lans. 4004

Miss 4539

DST 4539-47 opn $\frac{1}{2}$ hr

Rec. 15' mud

Kinderhook 4640 Viola 4700

Simp. 4838 Arb. 4942

TD 4973 D&A

ABANDONED

County **Iowa** State **Kansas**

Sec. 4 (Bk. 30 (S. 16W Map No.

Operator Lewis Travis

Well No. 1 Farm Miller

Elev.	Location	SW	SW	NW
-------	----------	----	----	----

0

FIRST REPORT

330 Ft. From S Line NW

330 Ft. From W Line Quarter

1st. Report MAY 9 1951

Completion

Remarks Phillips DEIM

Spudding Date 5-6-51

Drlg. Data

8" @ 478 drlg. 1400

J. E. TYRA

County Kiowa State Kansas
 Sec. 4 (Blk.) 30 (Sur.) 16W Map No.
 Operator Lewis Travis
 Well No. 1 Farm Millar
 Elev. 1850 Location SW SW NW



330 Ft. From S Line NW
330 Ft. From W Line Quarter

Ist. Report

Completion MAY 29 1951

Remarks

Spudding Date 5-6-51

Drlg. Data D & A TD 4973

8" @ 478 Heeb. 3787 Br. lime 3986

Lans. 4004 Miss. 4539 DST 4539-47

open $\frac{1}{2}$ hr. Rec. 15' mud Kinderhook 4640

Viola 4700 Simp. 4838 Arb. 4942

TD 4973 D & A

J. E. TYRA