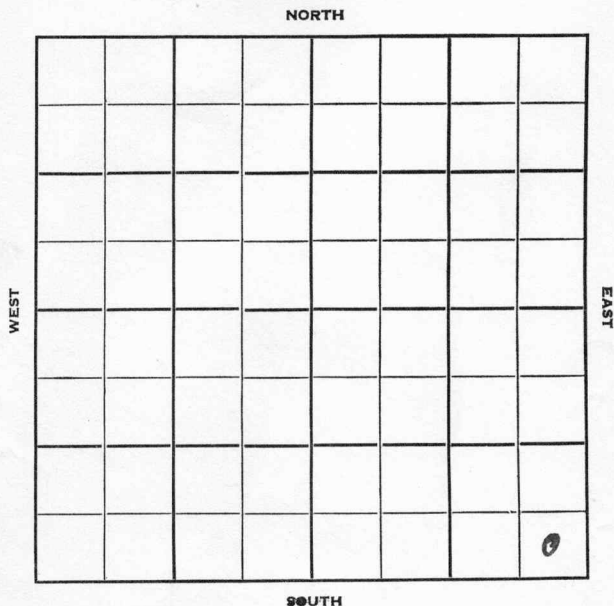


Section 4 Township 30 Range 11 WWell No. # 1 MeeksCompany W. J. Coppinger

HOT FILE

Barber KANSAS ✓

Sec. 4 Twp. 30 R. 11 WWell No. # 1 Meeks FarmW. J. Coppinger Company ²⁹⁵W. J. Coppinger Contractor

Wildcat


Ft. from N. Line

330 Ft. from S. Line330 Ft. from E. Line

Ft. from W. Line

SE SE SE

MCPC has SE/4 of 33-29-11 W

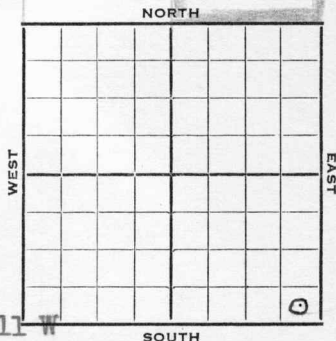

1952 Elev. 1822' REPORT

9/17 Location

9/24 RUR

10/1 8" @ 393'

Drlg. 3045'

10/15 Spud Date: 9-24-52

Drlg. Data: D&A TD 4880'

8" @ 383

Top. 3402, Doug 3725

DST 3726-63, opn 1 hr., rec. 90' gcm

270' gassy wtr 1050#

Lans. 3869, Miss 4652

DST 4384-87, opn 40 mins., rec. 15'
mud & SSO

Viola 4659, Simp 4738, Arb. 4829

TD 4880'

Schlumberger tops: Heeb 3656, Doug.

3725, Lans 3866', Miss 4368, Viola

4659', Simp. 4750', Arb. 4828'

D&A

ABANDONED

County Barber State KansasSec. 4 (Blk.) 30 (Sur.) 11W Map No.Operator W. J. CoppingerWell No. 1 Farm MeeksElev. _____ Location SE SE SE

330 Ft. From S Line SE330 Ft. From E Line Quarter1st. Report SEP 17 1952

Completion _____

Remarks _____


W. J. Coppinger - Contr.

Spudding Date _____

Drlg. Data MCPC has SE/4 of 33-29-11W WildcatLocation

J. G. McGEHEE

County Barber State Kansas
 Sec. 4 (Blk.) 30 (Sur.) 11W Map No.
 Operator W. J. Coppinger
 Well No. 1 Farm Meeks
 Elev. 1822 Location SE SE SE

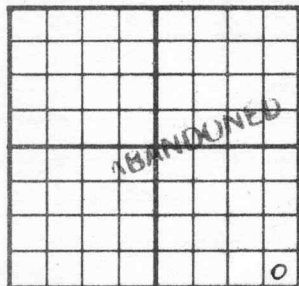

330 Ft. From S Line SE
330 Ft. From E Line Quarter
 1st. Report
 Completion OCT 15 1952
 Remarks Wildcat
Coppinger - Contr.
 Spudding Date 9-24-52

Drlg. Data D & A TD 4880
8" @ 393 Top. 3402 Doug. 3725
DST 3726-63 open 1 hr. Rec. 90' gcm
270' gassy water 1050# Lans. 3869
Miss. 4652 DST 4384-87 open 40 min.
Rec. 15' mud & SSO Viola 4659
Simp. 4738 Arb. 4829 TD 4880

D & A

SCHLUMBERGER TOPS

Heeb. 3656 Doug. 3725 Lans. 3866
Miss. 4368 Viola 4659 Simp. 4740
Arb. 4828

J. G. McGEHEE