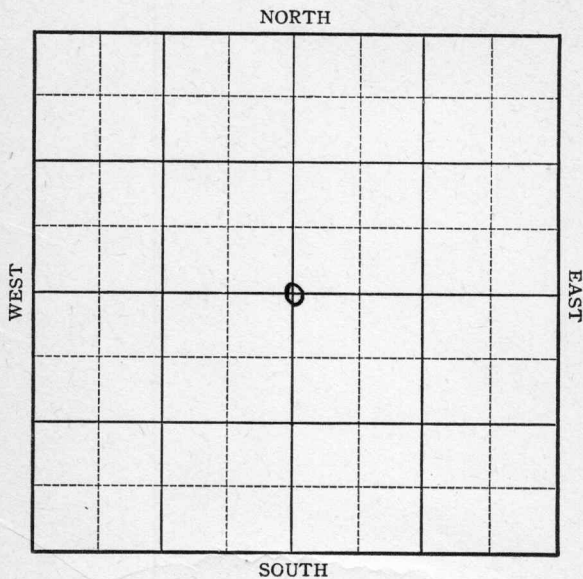


KANSAS

Grant

Section 4 Township 30 Range 36WWell No. 2 J. AlfordCompany United Prod.

KANSAS

Grant County

Sec. 4 Twp. 30 R. 36WWell No. #2 J. Alford FarmUnited Prod. Company

Hugoton


2640 Ft. from N. Line

Ft. from S. Line

2640 Ft. from E. Line

Ft. from W. Line

C Sec.

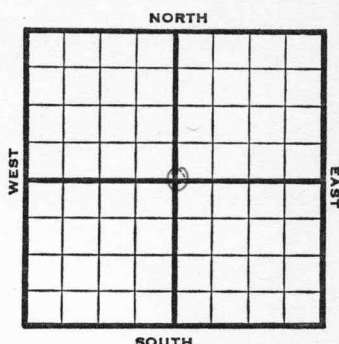

1946 Elev. 3033 REPORT

5/15 Location

5/21 Drlg 500'

5/29 10" @ 620
Drlg. 2000'6/5 TD 2820
7" @ 2820 RUST6/12 96 shots 2744 to 2796
500 acid

6/18 2000 acid SD & W PB 2731'

6/26 112 shots 3645-2706
5500 acid
88 shots 2566-88
5000 acid7/3 7" @ 2820
Perf. 10,000 acid.
TD 2820
10,100,000 Gas.
421# R Pr.

COMPLETED

KANSASKansas Pool Name HugotonMap No. ✓ Sec. 4 Twp. 30 R. 36WWell No. 2 J. AlfordUnited Prod.


Company

FIRST REPORT

Contractor

C SEC

SECTION PLAT

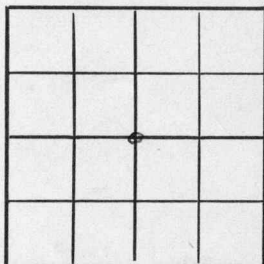2640 Ft. from N. Line Ft. from S. Line2640 Ft. from E. Line Ft. from W. LineGrant CountyLocation ✓Rig up

Drilling and Remarks:

RECORD

Cased in., ft.Sand Gas Oil Total Depth

PRODUCTION

✓ 1st 24 hrs. Nat. 1st 24 hrs. after shot Gas Cu. Ft.Dry Hole Abandoned

Date

MAY 15 194619S. J. LEWISScout

KANSAS

Kansas


Pool Name Hugoton PoolMap No. map Sec. 4 Twp. 30 R. 36WWell No. 2 J. AlfordUnited Prod.

Company

COMPLETED

Contractor

C Sec.

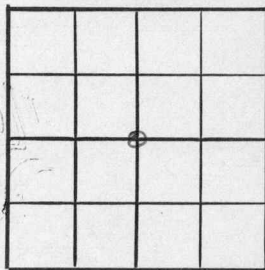E13033
SECTION PLAT2640 Ft. from N. Line

Ft. from S. Line

2640 Ft. from E. Line

Ft. from W. Line

Grant County

Location

Rig up

Drilling and Remarks:

7" C 2820Prof.10000 acid10,100,000 Gas421 # R P**RECORD**

Cased, _____ in., _____ ft.

Sand _____

Gas _____

Oil _____

Total Depth 2820**PRODUCTION**

1st 24 hrs. Nat. _____

1st 24 hrs. after shot _____

Gas _____ Cu. Ft.

Dry Hole _____

Abandoned 1

Date

JUL 3 1946 19S. J. LEWIS

Scout