

DX 78-1 Kingman


KANSAS

Section 4 Township 30 Range 6W

Well No. ~~#2~~ ^{#3} Ravenstein

Company McKnab & Lindsay

NORTH

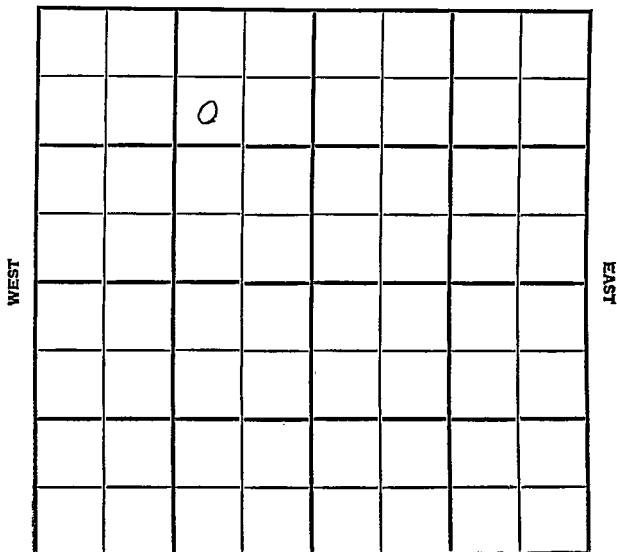

SOUTH

WEST

EAST

Kingman


SEC. # 4	TWP. 30	R. 6W
-------------	------------	----------

WELL NO. # ~~2~~ ³ Ravenstein FARM

COMPANY McKnab & Lindsay

CONTRACTOR McKnab
Rosedale

_____ FT. FROM N. LINE
 _____ FT. FROM S. LINE
 _____ FT. FROM E. LINE
 _____ FT. FROM W. LINE

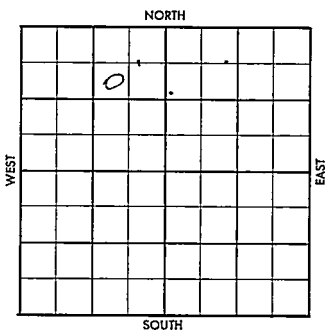

SW NE NW

1956	ELEVATION 1461'	REPORT
------	--------------------	--------

7-3 Comm. 6-29-56
 10" @ 160 w/125
 Drlg. 1690'

8-8 5 1/2" @ 3730
 To be SWD Well
 DST 3505-25 op 1 hr., 600' gas, rec.
 240' SOCM&W / 30' SW, 1030/20".
 DST 3541-55 op 45 min. gas in 55 min.
 rec. 180' HO&GCM / 30' free oil /
 330' SW, 1470/20".
 CO 78/3238-58
 Comp. SWDW.
 L. 3221'; KC 3498';
 TD 3730'

ABANDONED

~~27~~

County Kingman Elev. _____
 Sec. 1 Twp. 30 Rge. 6W
 Company McKnab & Lindsay
 Farm Name Ravenstein No. 2

Co.
Lse.
No.
Sec.
T.
R.

TOPS	DEPTH	LOG	DATUM
Anh.			
Tp.			
H.			
Tr.			
Dg.			
Bl.			
L.			
K.C.			
B.K.C.			
Ce.			
C.			
M.			
M.			
K.			
Mz.			
Mo.			
V.			
S.			
S.			
A.			
R.			
Pe.			
G.			
Ed.			

Loc. in Sec. SW NE NW
 Geol. _____
 Contr. McKnab
 Pool Rosedale

	0	

FIRST REPORT
 JUL 3 '56

Date Comm. 6-29-56
10" @ 160/125 drlg. 1690

0001 1 1 III

0001 0001

CORRECTION

FORM 513 SUNRAY

County Kingman Elev.
 Sec. 1- Twp. 30 Rge. 6W
 Company McKnab & Lindsay
 Farm Name Ravenstein No. 23

TOPS	DEPTH	LOG	DATUM	Loc. in Sec.									
Anh.				SW 1/4									
Tp.													
H.													
Tr.													
Dg.													
Bl.													
L. <u>3221</u>	<u>3708</u>			Geol.									
K.C. <u>3498</u>													
B.K.C.				Contr.									
Ce.													
C.				McKnab									
M.	<u>3757</u>												
M.				Pool									
K.													
Mz.				Rosedale									
Mo.													
V.				<table border="1" style="width: 100%; height: 100%; border-collapse: collapse;"> <tr> <td style="text-align: center;">S</td> <td></td> <td></td> </tr> <tr> <td></td> <td></td> <td></td> </tr> <tr> <td colspan="3" style="text-align: center; font-weight: bold; font-size: 1.5em;">ABANDONED</td> </tr> </table>	S						ABANDONED		
S													
ABANDONED													
S.	<u>4273</u>												
S.	<u>4305</u>												
A.													
R.													
PE.													
G.													
TD.	<u>3730</u>												

Date Comm. 6-29-56 AUG 8 '56

10" 160/125 drl. 1 70 JUL 11 '56

10 3632 JUL 18 '56 5 1/2 @ 3730³⁰

To be SWD well JUL 25 '56 AUG 1 '56

DST 3505-25 1/4 600 900 res

240' 50 CM & W + 30' SW 10.30/20"

DST 3541-55 45" 9/55" res

180' HO & 6 CM + 30' Free oil +

330' SW 1470/20" WOCT

AUG 13 '56 CO 28/3238-58 comp)

SWD well.