


Kingman

KANSAS

SECTION 4 TOWNSHIP 30S RANGE 8W

WELL NO. #1 Berthoff

COMPANY C.S.O. & Petroleum Inc.

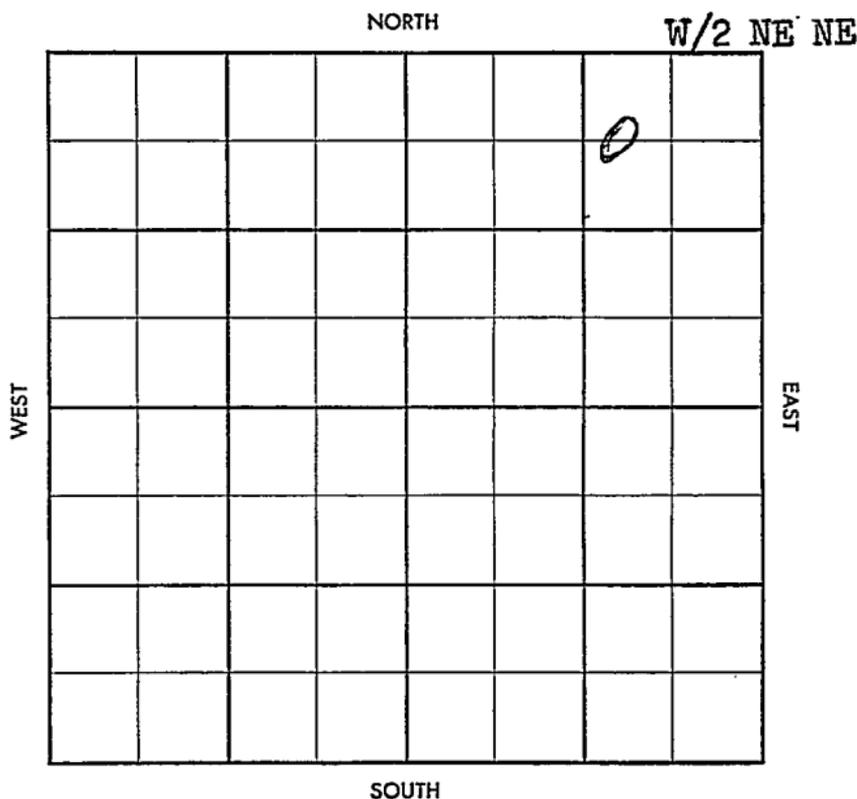

~~Twp.~~ ~~Pool~~
~~Co.~~ ~~Foot~~

S-513-B


County Kingman Elev. _____
 Sec. 4 Twp. 30 Rge. 8W
 Company G. S. O. & Petroleum Inc.
 Farm Name Berthoff No. 1

TOPS	DEPTH	LOG	DATUM	Loc. in Sec. _____
Anh.				<u>N/2 NE NE</u>
Tp.				
H.				
Tr.				
Dg.				
B.L.				
L.				
K.C.				Geol. _____
B.K.C.				Contr. _____
Ce.				<u>Garvey #5</u>
C.				
M.				Pool _____
M.				<u>Spivey-Grabs</u>
K.				
Mz.				
Mq.				
V.				
S.				
S.				
A.				
R.				
Pf.				
G.				
T.D.				

FIRST REPORT
MAR 26 58

Date Comm. 3/22/58
13" @ 15 w/100, 8" @ 400 w/250 Drlg. 1165

Co.
Lse.
No.
Sec.
T.
R.

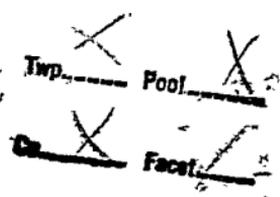

S-513-B

County Kingman Elev. 1578 or 1581 RR
 Sec. 4 Twp. 30 Rge. 8W
 Company C. S. O. & Petroleum Inc.
 Well Name Berthoff No. 1

STOPS	DEPTH	LOG	DATUM	Loc. in Sec.
Anh.				
Tp.				N/2 NW/4
H.	3220			
Tr.	3235			
Dg. <u>Sh</u>	3254			
B.L.				
L.	3440			
K.C.				Geol.
B.K.C.	3931			Contr.
Ce.				Garvey #5
C.				Pool
M.	4154			Spivey-Grabs
M. <u>LI</u>	4239			
K.				
Mz.				
Mq.				
V.				
S.				
S.				
A.				
R.				
Pf.				
G.				
T.D.	4270			

0
 MAY 7 '58
 COMPLETE

Date Comm. 3/22/58
 13" @ 115 w/100, 9" @ 400 w/250 Drlg. 1165
 APR 2 '58 @ 3776 APR 9 '58 DST 4155-70
 of 1 hr g/12" ga 2.310 m/130
 60' M BHP 1550/30 DST FP 215
 - 320 DST 4170 - 90 of 1 hr g/11 1/2"
 ga 2.790 m/130" 55' M BHP
 1575/30" FP 200-320 DST 4190
 - 4205 of 1 hr g/11" ga 2.600
 m/130" 5' M BHP 1615/30" FP 112
 - 4215 DST 4205 - 4220 of 1 hr

9/1 1/4" ga 7.120 met 26 M
 BHP 1610/30 EP 830-1035 DST
 4220-4235 op 1hr 9/1 1/2" ga
 3.210 met 130" ne 20' M gray
 25' Oil M BHP 1615/30" DST
 4235-50? op 1hr 9/1 1/2" ga 5.210
 met 150" 90' oil EP 630-975
 BHP 1615 ~~at~~ run log APR 10 58
 S ~~4269~~ APR 23 58 CO 223/4151
 -4206 fld F10 5.692 met
 S1TP 1340 CP 1110
 2hr B10 D 5.692 met 3 point
 6.100 met APR 23 58 APR 23 58
 op F10 12.760 MCF S1TP 1442
 SIC 1440

4=30-8W

W/2 NE NE