FORM 51 25M 8-50 WESTERN


KANSAS

Grant

Section 4 Township 30 Range 37W

Well No. #1-4 Hildebrand

Company Hugoton Prod.

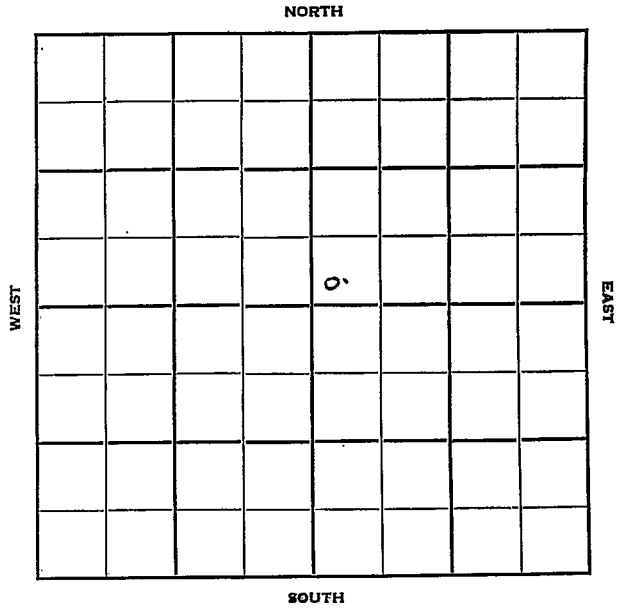

FORM 252-B
10M 11-50 PETROL

KANSAS

Sec. 4 Twp. 30 R. 37W Grant

Well No. #1-4 Hildebrand Farm

Hugoton Prod. Company

Moran - Contr. Contractor

Hugoton Pool


2400' Ft. from N. Line

Ft. from S. Line

Ft. from E. Line

2840' Ft. from W. Line

SW NE

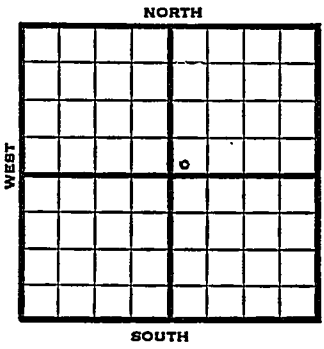

1951	Elev. 3092' REPORT
4/4	Location
8/8	Spud 5-20-51 Gas well TD 2655' 10" @ 540' 7" @ 2406' TD 2655' Her. 2406' Krider 2421-87' Win. 2497-2541' Ft. Riley 2561-93' 20,000 A Comp. 38,447,000 gas 421# COMPLETED

FORM 275 FOR SALE BY KANSAS BLUE PRINT CO.


County Grant State Kansas

Sec. 4 (Blk. Twp.) 30 (Sur. Rge.) 37W Map No.

Operator Hugoton Prod.

Well No. 1-4 Farm Hildebrand

Elev. Location SW NE

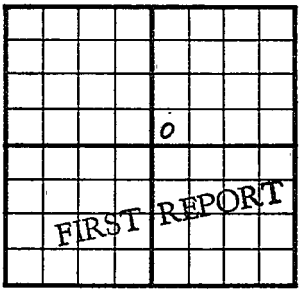

2400 Ft. From N Line NE

2840 Ft. From W Line Quarter

Ist. Report APR 4 1951

Completion

Remarks

Moran - Contr.

Spudding Date

Drlg. Data Hugoton Pool

Location

J. E. TYRA

FORM 275 FOR SALE BY KANSAS BLUE PRINT CO.


County Grant State Kansas

Sec. 4 (Blk. Twp.) 30 (Sur. Rge.) 37W Map No.

Operator Hugoton Prod.

Well No. 1-4 Farm Hildebrand

Elev. 3092 Location SW NE

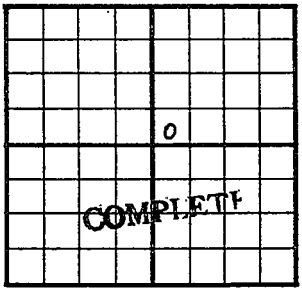

2400 Ft. From N Line Sec.

2840 Ft. From W Line Quarter

1st. Report

Completion AUG 8 1951

Remarks Hugoton Pool

Moran - Contr.

Spudding Date 5-20-51

Drlg. Data Gas well TD 2655

10" @ 540 7" @ 2406 TD 2655

Her. 2406 Krider 2421-87 Win. 2497-2541

Ft. Riley 2561-93 20000 A

Comp. 38,447,000 gas 421#

J. E. TYRA