

# KANSAS


FORM 51 5M 6-46 PETROL

Stanton county

Section 4 Township 30 Range 39-W

Well No. #1, Sheltar

Company Stanolind Oil and Gas Company

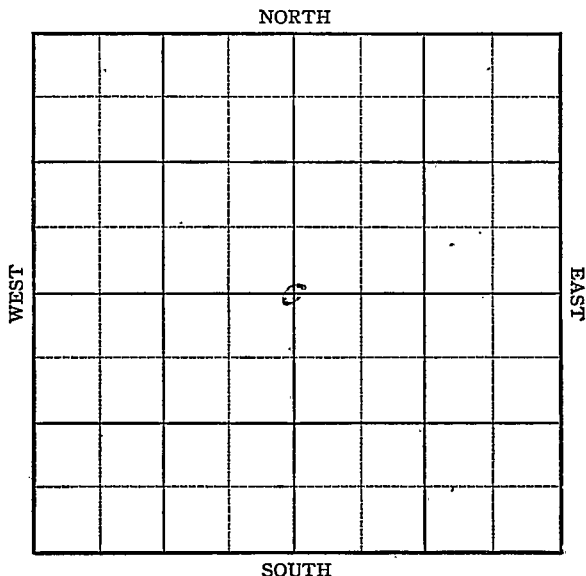

KANSAS

Stanton County ✓

Sec. 4 Twp. 30 R. 39W

Well No. 1 Sheltar Farm

Stanolind Company


Hugoton Pool

2640 Ft. from N. Line

Ft. from S. Line

2640 Ft. from E. Line

Ft. from W. Line

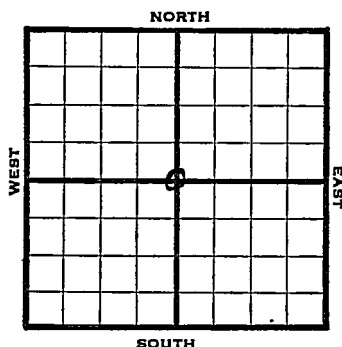

G. Sec.

| 1947 | Elev. 1641                    | REPORT |
|------|-------------------------------|--------|
| 1/2  | RUR                           |        |
| 1/8  | 8" @ 600'                     |        |
|      | TD 2524'                      |        |
|      | Run 5"                        |        |
| 1/15 | 5" @ 2484                     |        |
|      | 3000 Acid                     |        |
| 1/21 | Plug 2475                     |        |
|      | 108 shots 2445-63             |        |
| 1/30 | Plug 2430-204 shots 2369-2403 |        |
|      | 4500 Acid                     |        |
|      | Plug 2475-270 shots 2303-48   |        |
|      | 5500 Acid                     |        |
| 2/5  | " "                           | "      |
| 2/12 | " "                           | "      |
| 2/19 | " "                           | "      |
| 2/26 | " "                           | "      |
| 3/5  | 5" @ 2484                     |        |
|      | Perf                          |        |
|      | 14000 Acid                    |        |
|      | 8,600,000 Gas                 |        |
|      | TD 2524'                      |        |

COMPLETED

Map No. \_\_\_\_\_ Sec. 4 Twp. 30 R. 39WWell No. 1 Sheltar

Stanolind

Company

## FIRST REPORT

Contractor

C Sec.


## SECTION PLAT

2640 Ft. from N. Line

\_\_\_\_\_ Ft. from S. Line

2640 Ft. from E. Line

\_\_\_\_\_ Ft. from W. Line

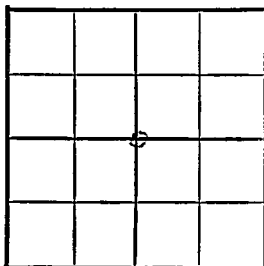

Stanton County

Location \_\_\_\_\_

Rig up \_\_\_\_\_

Drilling and Remarks: \_\_\_\_\_

R U R

## RECORD

Cased \_\_\_\_\_ in., \_\_\_\_\_ ft.

Sand \_\_\_\_\_

Gas \_\_\_\_\_

~~Oil~~ \_\_\_\_\_

Total Depth \_\_\_\_\_

## PRODUCTION

1st 24 hrs. Nat. \_\_\_\_\_

1st 24 hrs. after shot \_\_\_\_\_

Gas \_\_\_\_\_ Cu. Ft.

Dry Hole \_\_\_\_\_

Abandoned \_\_\_\_\_

Date

JAN 2 1947 19

S. J. LEWIS

Scout

Kansas

Map No. \_\_\_\_\_ Sec. 4 Twp. 30 R. 39WWell No. 1 SheltarStanolind

Company

COMPLETE

Contractor


C Sec.

E18201  
SECTION PLAT2640 Ft. from N. Line

\_\_\_\_\_ Ft. from S. Line

2640 Ft. from E. Line

\_\_\_\_\_ Ft. from W. Line

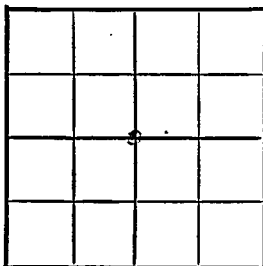

Stanton County

Location \_\_\_\_\_

Rig up \_\_\_\_\_

Drilling and Remarks:

5" C62484Perf8,600,000 Gas

## RECORD

Cased \_\_\_\_\_ in, \_\_\_\_\_ ft.

Sand \_\_\_\_\_

Gas \_\_\_\_\_

Oil \_\_\_\_\_

Total Depth 23-24

## PRODUCTION

1st 24 hrs. Nat. \_\_\_\_\_

1st 24 hrs. after shot \_\_\_\_\_

Gas \_\_\_\_\_ Cu. Ft.

Dry Hole \_\_\_\_\_

Abandoned \_\_\_\_\_

Date

MAR 5 1947 19

S. J. LEWIS

Scout