

STATE CORPORATION COMMISSION OF KANSAS
OIL & GAS CONSERVATION DIVISION
WELL COMPLETION OR RECOMPLETION FORM
ACO-1 WELL HISTORY

DESCRIPTION OF WELL AND LEASE

Operator: license # 5363
name BEREVCO INC.
address 970 Fourth Financial Center
City/State/Zip Wichita, Ks. 67202

Operator Contact Person Pete Wilson
Phone (405) 848-1165

Contractor: license # 5147
name BEREDCO INC.

Wellsite Geologist Edwin H. Grieves
Phone (405) 721-2124

PURCHASER

Designate Type of Completion
 New Well Re-Entry Workover

- Oil SWD Temp Abd
- Gas Inj Delayed Comp.
- Dry Other (Core, Water Supply etc.)

WFO: old well info as follows:
Operator
Well Name
Comp. Date Old Total Depth

WELL HISTORY

Drilling Method: Mud Rotary Air Rotary Cable
7/6/85 7/20/85 7-20-85
Spud Date Date Reached TD Completion Date

5600
Total Depth PBSD

Amount of Surface Pipe Set and Cemented at 1552' feet

Multiple Stage Cementing Collar Used? Yes No

If Yes, Show Depth Set feet

If alternate 2 completion, cement circulated from feet depth to w/ SX cmt

API NO. 15 - 15-187-20,394
County STANTON
SW NW SE 14 30S 41W
(location) Sec Twp Rge

1750 Ft North from Southeast Corner of Section
2530 Ft West from Southeast Corner of Section
(Note: locate well in section plat below)


Lease Name Naomi Well# 3

Field Name

Producing Formation

Elevation: Ground 3358' KB 3371'

Section Plat

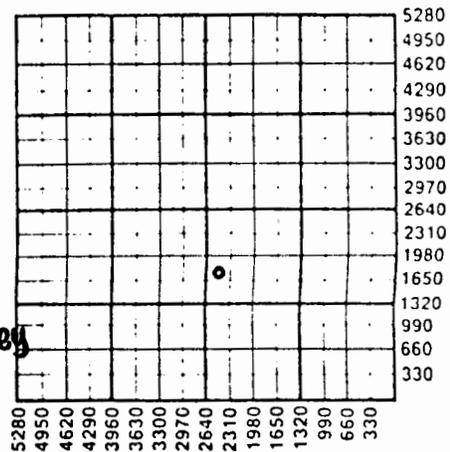

AUG 19 1985

State Geological Survey
WICHITA BRANCH

WATER SUPPLY INFORMATION

Source of Water:
Division of Water Resources Permit #

Groundwater Ft North From Southeast Corner and Ft. West From Southeast Corner of (Well) Sec Twp Rge East West

Surface Water Ft North From Southeast Corner and (Stream, Pond etc.) Ft West From Southeast Corner Sec Twp Rge East West

Other (explain) Purchased from Steve Tucker (purchased from city, R.W.D.#)

Disposition of Produced Water: Disposal Repressuring

Docket #

INSTRUCTIONS: This form shall be completed in duplicate and filed with the Kansas Corporation Commission, 200 Colorado Derby Building, Wichita, Kansas 67202, within 90 days after completion or recompletion of any well. Rules 82-3-130 and 82-3-107 apply.

Information on side two of this form will be held confidential for a period of 12 months if requested in writing and submitted with the form. See rule 82-3-107 for confidentiality in excess of 12 months.

One copy of all wireline logs and drillers time log shall be attached with this form. Submit CP-4 form with all plugged wells. Submit CP-111 form with all temporarily abandoned wells.