

15-187-20268 *And* AUG

State Geological Survey
WICHITA, BRANCH

KANSAS DRILLERS LOG

API No. 15 — 187 — 20268
County Number

S. 22 T. 30S R. 41W E
Loc. NE NE SE
County Stanton

Operator
Beren Corporation

Address
970 Fourth Financial Center, Wichita, Kansas 67202


Well No. 1 Lease Name CARRIE

Footage Location
feet from (N) (S) line feet from (E) (W) line

Principal Contractor Da Mac Drilling Geologist
Date: APR 30 1982

Spud Date May 9, 1978 Total Depth 5600 P.B.T.D. FROM CONFIDENTIAL

Date Completed May 26, 1978 Oil Purchaser
DF KB

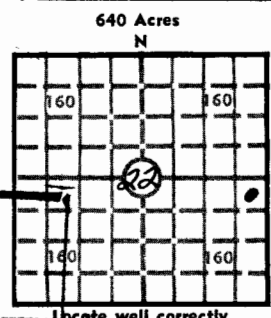

CASING RECORD

Report of all strings set — surface, intermediate, production, etc.

Purpose of string	Size hole drilled	Size casing set (in O.D.)	Weight lbs/ft.	Setting depth	Type cement	Sacks	Type and percent additives
Surface		8-5/8		1580	Common Halco-Lite	150 600	
Production		5 1/2	14#	5604	60-40 poxmox	300	

LINER RECORD

PERFORATION RECORD

Top, ft.	Bottom, ft.	Sacks cement	Shots per ft.	Size & type	Depth interval

Size	Setting depth	Packer set at

ACID, FRACTURE, SHOT, CEMENT SQUEEZE RECORD

Amount and kind of material used	Depth interval treated

INITIAL PRODUCTION

Date of first production		Producing method (flowing, pumping, gas lift, etc.)			
RATE OF PRODUCTION PER 24 HOURS	Oil	Gas	Water	Gas-oil ratio	
	bbls.	MCF	bbls.	CFPB	
Disposition of gas (vented, used on lease or sold)			Producing interval (s)		

INSTRUCTIONS: As provided in KCC Rule 82-2-125, within 90 days after completion of a well, one completed copy of this Drillers Log shall be transmitted to the State Geological Survey of Kansas, 4150 Monroe Street, Wichita, Kansas 67209. Copies of this form are available from the Conservation Division, State Corporation Commission, 3830 So. Meridian (P.O. Box 17027), Wichita, Kansas 66217. Phone AC 316-522-2206. If confidential custody is desired, please note Rule 82-2-125. Drillers Logs will be on open file in the Oil and Gas Division, State Geological Survey of Kansas, Lawrence, Kansas 66044.

Operator Beren Corporation		DESIGNATE TYPE OF COMP.: OIL, GAS, DRY HOLE, SWDW, ETC.:	
Well No. 1	Lease Name CARRIE		Gas
S <u>22</u> T <u>30</u> R <u>41</u> W ^E _W			
WELL LOG		SHOW GEOLOGICAL MARKERS, LOGS RUN, OR OTHER DESCRIPTIVE INFORMATION.	
Show all important zones of porosity and contents thereof; cored intervals, and all drill-stem tests, including depth interval tested, cushion used, time tool open, flowing and shut-in pressures, and recoveries.			
FORMATION DESCRIPTION, CONTENTS, ETC.	TOP	BOTTOM	NAME
Sand, red bed	0	765	
Red bed, Anhydrite	765	1215	
Anhydrite, sand	1215	1556	
Anhydrite, red bed	1556	1681	
Red bed, shale	1681	2730	
Shale, Dolomite	2730	2910	
Lime, shale	2910	5606	
USE ADDITIONAL SHEETS, IF NECESSARY, TO COMPLETE WELL RECORD.			
Date Received	 Signature Don Beauchamp - Geologist Title February 2, 1979 Date		

b15 h11