

STATE CORPORATION COMMISSION OF KANSAS
OIL & GAS CONSERVATION DIVISION

WELL COMPLETION OR RECOMPLETION FORM
ACO-1 WELL HISTORY

DESCRIPTION OF WELL AND LEASE

Operator: license # 5363
name BEREXCO INC.
address 970 Fourth Financial Center
City/State/Zip Wichita, KS 67202

Operator Contact Person Evan Mayhew
Phone 1-316-265-3311

Contractor: license # 5147
name Beredco Inc.

Wellsite Geologist Greg Pais
Phone 1-405-721-2124

PURCHASER Central Crude Corporation

Designate Type of Completion

☒ New Well ☐ Re-Entry ☐ Workover

☒ Oil ☐ SWD ☐ Temp Abd
☐ Gas ☐ Inj ☐ Delayed Comp.
☐ Dry ☐ Other (Core, Water Supply etc.)

OWWO: old well info as follows:

Operator
Well Name
Comp. Date Old Total Depth

WELL HISTORY

Drilling Method: ☒ Mud Rotary ☐ Air Rotary ☐ Cable

12/30/84 01/17/85 05/18/85
Spud Date Date Reached TD Completion Date

50' 5600'
Total Depth PBTD

Amount of Surface Pipe Set and Cemented at 1554' feet

Multiple Stage Cementing Collar Used? ☐ Yes ☒ No

If Yes, Show Depth Set feet

If alternate 2 completion, cement circulated
from feet depth to w/ SX cmt

API NO. 15-187-20,379

County Stanton

C SE SE Sec 33 Twp 30 S Rge 41 W XX West
(location)

660 Ft North from Southeast Corner of Section

660 Ft West from Southeast Corner of Section

(Note: locate well in section plat below)


Lease Name Lawson Well# 1

Field Name Beauchamp, SW

Producing Formation Keyes

Elevation: Ground 3409 KB 3422

Section Plat

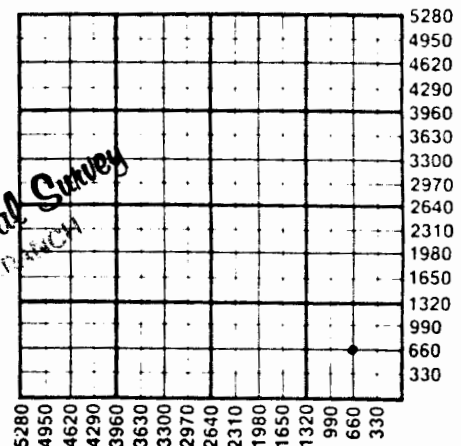

WATER SUPPLY INFORMATION

Source of Water:

Division of Water Resources Permit #

☐ Groundwater. Ft North From Southeast Corner and
(Well) Ft. West From Southeast Corner of

Sec Twp Rge ☐ East ☐ West

☐ Surface Water. Ft North From Southeast Corner and
(Stream, Pond etc.) Ft West From Southeast Corner

Sec Twp Rge ☐ East ☐ West

☒ Other (explain) Glen Tucker
(purchased from city, R.W.D.#)

Disposition of Produced Water: ☐ Disposal
☐ Repressuring

Docket # NA

INSTRUCTIONS: This form shall be completed in duplicate and filed with the Kansas Corporation Commission, 200 Colorado Derby Building, Wichita, Kansas 67202, within 90 days after completion or recompletion of any well. Rules 82-3-130 and 82-3-107 apply.

Information on side two of this form will be held confidential for a period of 12 months if requested in writing and submitted with the form. See rule 82-3-107 for confidentiality in excess of 12 months.

One copy of all wireline logs and drillers time log shall be attached with this form. Submit CP-4 form with all plugged wells. Submit CP-111 form with all temporarily abandoned wells.