

15-187-20377

14-30-41W

PLAT #1115841

BARNEY ROGERS DIRT CONTRACTOR, INC
 BOX 492
 ULYSSES, KANSAS
GAS-OIL WELL LOCATIONS AND/OR ELEVATIONS

DATE 11-16-84

OPERATOR Brexco


LOCATION Stanton 14 30s 41w Naomi #1
 county sec tow ran well name

FOOTAGES & RELATIONS 1500' FSL 3365 gr.
600' FLL ELEVATION

Well File

SCALE
 2" = 1 Mile

Stake, elevation
 & detectron.
 \$ 200.00
 Extra mileage
 \$ NC
 Total
 \$ 200.00

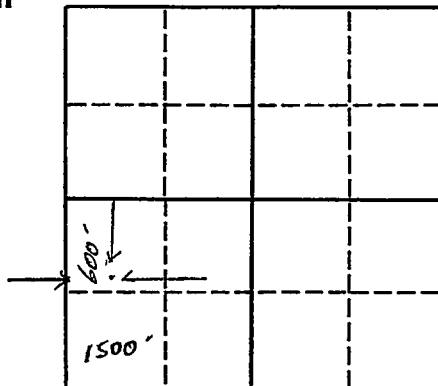

COMMENTS
Set 4' x 1/2' stake
Flagged
location is in
level Irrigator
mito
No Pipeline
No Waterwell

Authorized By:

Linda Stewart

Thank you,

Vernon C. Becker
 ULYSSES DISTRICT OFFICE
 316-356-2140
 316-356-4074

Janet

14-30-41W

S-187-2037
DEC 03 1984

PLAT # 1128842

BARNEY ROGERS DIRT CONTRACTOR, INC
BOX 492
ULYSSES, KANSAS
GAS-OIL WELL LOCATIONS AND/OR ELEVATIONS

DATE 11-28-84

OPERATOR Borexco Inc.

LOCATION Stanton 14 30 41 Naomi #1
 county sec town ran well name

FOOTAGES & RELATIONS 1696' FSL 3365 gr
 600' FWL ELEVATION

3375 DF

3377 KB

SCALE

2" = 1 Mile

Stake, elevation
& detection.
\$ 100.00
Extra mileage
\$ NC
Total
\$ 100.00

COMMENTS

Rerun on
elevation after
Rig move.

Authorized By:

Linda Stewart

Vernon C Becker
ULYSSES DISTRICT OFFICE

316-356-2140
316-356-4074