

Kiowa

KANSAS

5

30S

#

18W

SECTION \_\_\_\_\_ TOWNSHIP \_\_\_\_\_ RANGE \_\_\_\_\_

#1 Parkings "B"


WELL NO. \_\_\_\_\_

Northern Nat.

COMPANY \_\_\_\_\_

NORTH

C SW NW

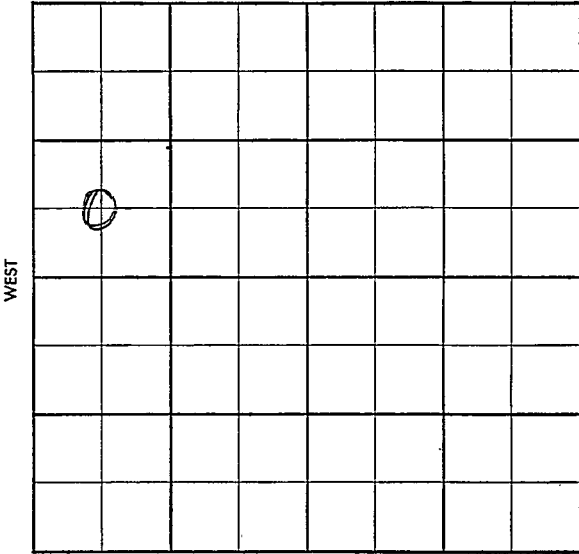

SOUTH



S-513-A

CO. Kigwa ELEV. 2257  
SEC. 5 TWP. 30 RGE. 18W  
COMPANY Northern Nat NO. 1

DEC 26 '57  
**COMPLETE**

FARM Parkins "B"  
LOC. C SW NW

Anhy. 559  
H 4174  
R 4188  
BL 4355  
L 4369  
Mar 4901  
C 4898  
M 4982  
TD 5080

GEOL. \_\_\_\_\_  
CONTR. Gabbert-Jones  
POOL SW Nichols  
SPUD 10-1-57  
8 5/8" @ 462  
drlg. 1890  
TD 4267  
OCT 2-57 DST 4987  
-5000 60" G 1/2"  
ga 340 M C P 15"

1 SE  
NO.  
SEC.  
TWP.  
RGE.

350 MEF 160" sec 15' GCM  
BHP 1675 40" DST 5000-15  
1 hr 15" - 30' M BHP 400 1/20"  
DST 5015-30 1 1/2 hrs  
100 S Gessy 60 CMB BHP 1555 1/20  
5" 5088 NOV 6 '57  
45002 Apr 3x3 sec 14'  
12 BHP 14-4070 W 7 hrs  
P & F 10 6.5 BO + 16 BW 24 hrs

P 46 BO + 16 BW 24 hrs  
WOP NOV 20 '57 DEC 26 '57  
P 40 BO P & + 16 BW

M 5002-