

Kiowa


KANSAS

SECTION 5 TOWNSHIP 30 RANGE 18W

WELL NO. #1 Parkin "C"

COMPANY Francis O&G

NORTH C NW NW

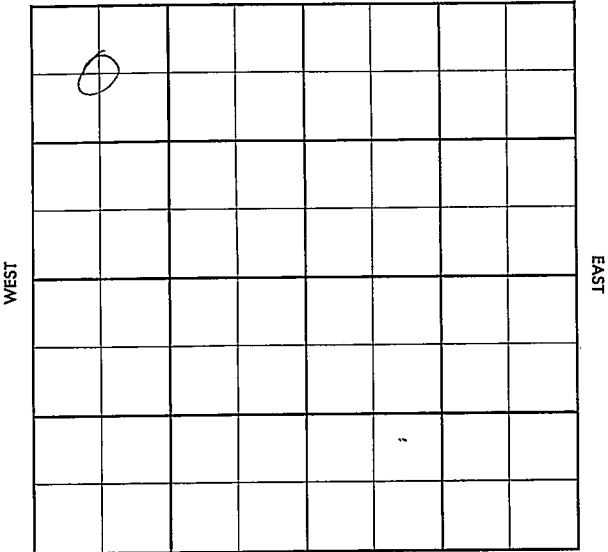

SOUTH

WILDCAT

County Kiowa Elev. _____
 Sec. 5 Twp. 30 Rgs. 18W
 Company Francis O & G
 Farm Name Parkin "G" No. 1

TOPS	DEPTH	LOG	DATUM
Anh.	<u>1147</u>		
Tr.			
H.			
Tr.			
Dg.			
Bl.			
L.			
K.C.			
B.K.C.			
Ce.			
C.			
M.			
M.			
K.			
Mz.			
Mo.			
V.			
S.			
S.			
A.			
R.			
Pe.			
G.			
T.D.			


Loc. in Sec. _____
C NW NW

Geol. _____
 Contr. _____
 Pool _____
Wildcat

MAR 13 1957

FIRST REPORT

Date Comm. 3-7-57 Gulf (DHM)
8 5/8" @ 408/225, Drlg. 2440

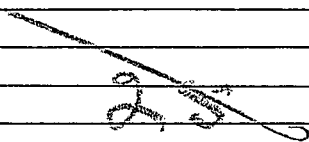

Co. Lse. No. Sec. T. R.

1hr 90' MCO + 3051' SWCEVHO
 CM (est 50% oil) FP 65-228
 BHP 1475/15 5 1/2 @ 5853 APR 10 '57
 MICT APR 17 '57 16/4976-80 24/
 4968-74 1/2 @ 3 Bopd +
 Tr wto Frac Flwd 8.19 BFP
 30% wto + est 1 Mill CFDP
 2 1/4" ch wopd APR 24 '57 MAY 1 '57 MAY 8 '57
 tst 74 B0 + 30% wto 2 1/4" ch
 Flw 57 B0 + 28 Bwpd + 590
 MCFG 2 1/4" ch FCP 500 #
 TP 175 # MAY 15 '57 MAY 22 '57 MAY 29 '57 JUN 5 '57
 JUN 12 '57 JUN 19 '57 JUN 26 '57 JUL 3 '57 P.
 52 B0 + 31 BW + 9a 304
 MCFG GOR 5700:1 JUL 10 '57
 JUL 17 '57 JUL 24 '57 JUL 31 '57 AUG 7 '57 AUG 14 '57
 GOR Test: 85 Bopd +
 40% wto GOR 2590:1