

KANSAS

FORM 5 5M PETROL

Barber

Section 5 Township 30 Range 14W

Well No. #1 Shriver

Company Ohio & Pryor & Lockhart et al.

NORTH

							O

SOUTH

WEST EAST

Sec. 5 Twp. 30 R. 14W

Well No. #1 Shriver Farm

Ohio & Pryor & Lockhart et al Company

Wildcat


NORTH

 Ft. from N. Line

330 Ft. from S. Line

330 Ft. from E. Line

 Ft. from W. Line

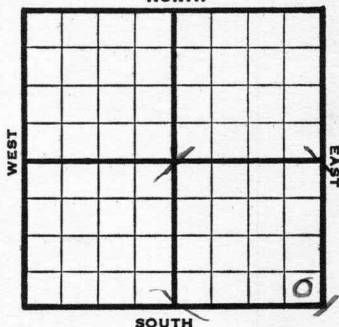

Elev. 1932

11944

REPORT

4/5	Location
4/12	Rotary
4/19	"
4/26	12" @ 290 -1575 hole 15 degrees off.
5/3	2070 Lost Circ PBl300'
5/10	Anhy 797 Topeka 3121 Drlg. 3412'
5/17	Lans. 3967 Gas 4012-18, 4070-84 T.D. 4199
5/24	Viola 4515 Simp. 4551 TD 4563 Run 7"
5/31	7" @ 4553 RUST
6/7	TD 4564 20 qts 4559-64 fsg.
6/15	" " " " "
6/21	" " " 2 "
6/28	" " " " "

OVER

1944

7/19

Arb. 4657

TD 4732

Water


ABANDONED

Pool Name WildcatMap No. KANSAS 72 Sec. 5 Twp. 30 R. 14WWell No. 1 ShriverOhio & Pryor & Lockhart et al. CompanyABANDONED

Contractor

SE/C

SECTION PLAT

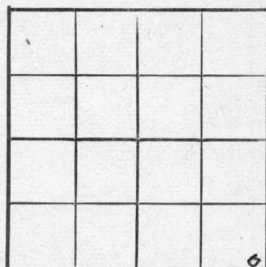

_____ Ft. from N. Line

330 Ft. from S. Line330 Ft. from E. Line

_____ Ft. from W. Line

Barber County

Location _____

Rig up _____

Drilling and Remarks:

CR 4657Water

RECORD

Cased _____ in., _____ ft.

Sand _____

Gas _____

Oil _____

Total Depth 4732

PRODUCTION

1st 24 hrs. Nat. _____

1st 24 hrs. after shot _____

Gas _____ Cu. Ft.

Dry Hole _____

Abandoned _____

Date

JUL 19 1944

19

S. J. LEWIS

Scout

Misc. Small Maps	<i>Oma</i>
Cards	<i>Betty</i>
Tracing	<i>MEL</i>
France Map	<i>M</i>
Scarborough Map	
Moody Map	
Geological Dept.	
Moody Plat Book	

Map No. 92 Sec. 5 Twp. 30 R. 14W

Well No. 1 Shriver


Ohio & Pryor & Lockhart et al. Company

FIRST REPORT

Contractor

SE/C

SECTION PLAT

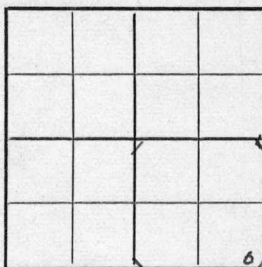

_____ Ft. from N. Line

330 Ft. from S. Line

330 Ft. from E. Line

_____ Ft. from W. Line

Wildcat

Location X

Rig up _____

Drilling and Remarks:

RECORD

Cased _____ in., _____ ft.

Sand _____

Gas _____

Oil _____

Total Depth _____

PRODUCTION

1st 24 hrs. Nat. _____

1st 24 hrs. after shot _____

Gas _____ Cu. Ft.

Dry Hole _____

Abandoned _____

Date

APR 5 1944 19

S. J. LEWIS Scout

PLAT

Map No. 30 Sec. 5 Twp. 30 R. 14


Wm. I. Driver

Ohio & Pryor & Lockhart et al. Company

Contractor

28/0

SECTION PLAT

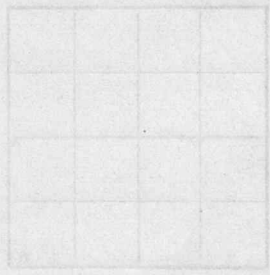

From N. Line
330 From S. Line
320 From E. Line
From W. Line

Wildcat

Location X

Big up
Drilling and Remarks

Misc. Small Maps	
Cards	<i>Madge</i>
Tracing	<i>Madge</i>
France Map	<i>Madge</i>
Scarborough Map	<i>Madge</i>
Pierce Map	<i>Madge</i>
Geological Dept.	
Pierce Plat Book	