


Section 5 Township 30 Range 15 W

Well No. # 1 Louise

Company Sinclair Oil & Gas

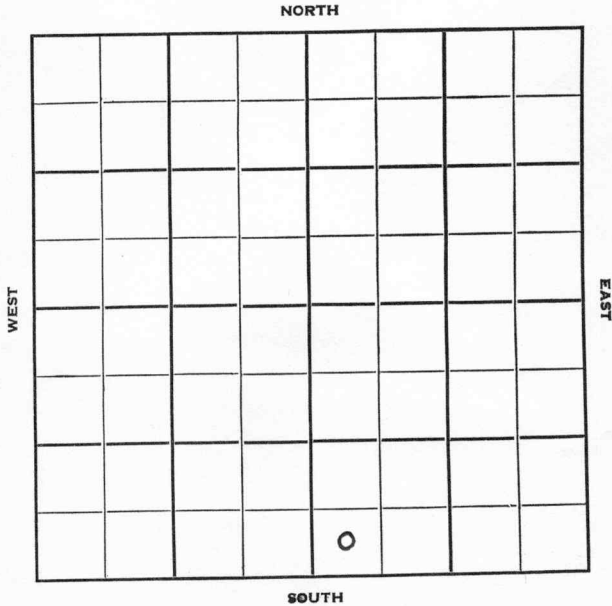

Barber

Sec. 5 Twp. 30 R. 15W

Well No. #1 Louise Farm

Sinclair O & G Company

Harbar Drlg. -Contr. Contractor

Wildcat


 Ft. from N. Line

330' Ft. from S. Line

 Ft. from E. Line

330' Ft. from W. Line

SW SW SE

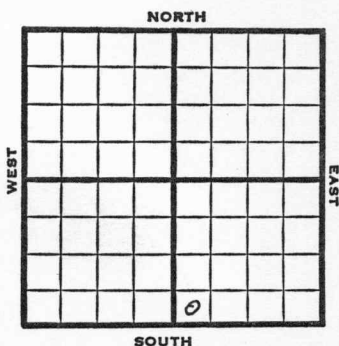


1951 Elev. 1980' REPORT

3/14 RUR

4/11 Spud 3-14-51
D&A TD 4928
10" @ 313
Br Lime 4069 KC 4084
Massey Zn 4545-50
Cong. 4624
Viola 4671 Simp. 4794
Arb. 4897 TD 4928'
D&A

ABANDONED

J. E. TYRA

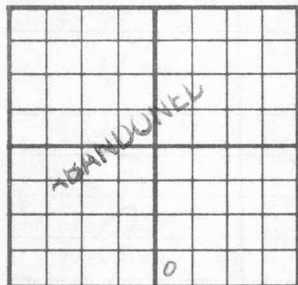County Barber State KansasSec. 5 (Blk.
Twp.) 30 (Sur.
Rge.) 15W Map No.Operator Sinclair Oil & GasWell No. 1 Farm LouiseElev. 1980 Location SW SW SE330 Ft. From S Line SE330 Ft. From W Line Quarter1st. ReportCompletion APR 11 1951Remarks WildcatHarbar Drlg. - Contr.Spudding Date 3-14-51Drlg. Data D & A TD 492810" @ 313 Br. lime 4069 KC 4084Massey zone 4545-50 Cong. 4624Viola 4671 Simp. 4794 Arb. 4897TD 4928 D & A

J. E. TYRA