

Barber


FORM 51 5M 6-46 PETROL

KANSAS

Section 5 Township 30 Range 11W

Well No. 1 Rolf

Company E. Wakefield

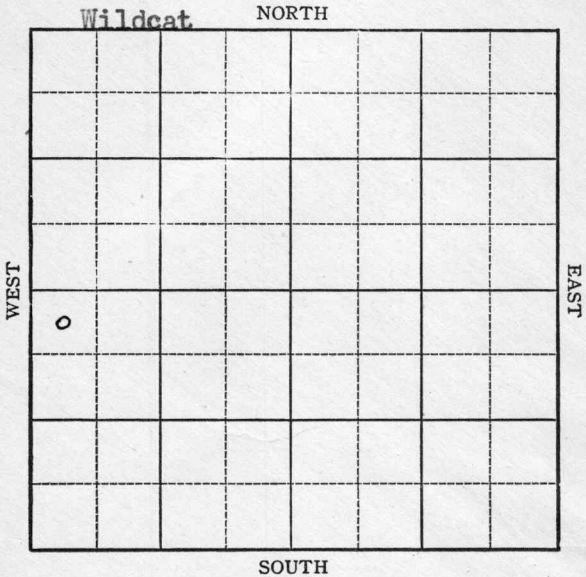

KANSAS

Barber county

Sec. 5 Twp. 30 R. 11W

Well No. 1 Rolf Farm

E. Wakefield Company

Wildcat

330

Ft. from N. Line


Ft. from S. Line

Ft. from E. Line

330

Ft. from W. Line

NW SW

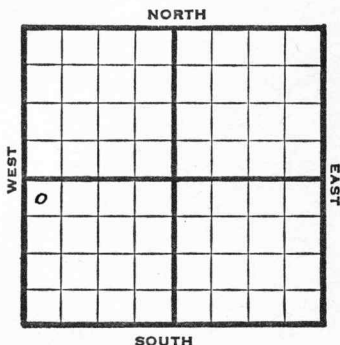

1947

Elev. 1842 REPORT

5/7

8" @ 230
Drlg. 9753'

5/13

Drlg 3620'

5/20

Lans 3859
Drlg 4275'

4700
1842
2858

5/27

Miss 4375
Viola 4666
Simpson 4700
Drlg. 4782

6/4

Arb. 4791'
TD 4839'

ABANDONED

Map No. K 54 Sec. 5 Twp. 30 R. 11W

Well No. 1 Rolf

E. Wakefield Company

FIRST REPORT Contractor

NW SW


SECTION PLAT

330 Ft. from N. Line

 Ft. from S. Line

 Ft. from E. Line

330 Ft. from W. Line

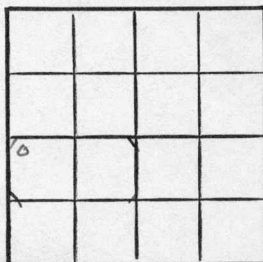

Barber County

Location

Rig up

Drilling and Remarks:

8" @ 230

drlg. 975

RECORD

Cased in., ft.

Sand

Gas

Oil

Total Depth

PRODUCTION

1st 24 hrs. Nat.

1st 24 hrs. after shot

Gas Cu. Ft.

Dry Hole

Abandoned

Date

MAY 14 1947

19

S. J. LEWIS

Scout

Map No. 54 Sec. 5 Twp. 30 R. 11W

Well No. 1 Rolf

E. Wakefield Company

ABANDONED

Contractor

NW SW


21, 1842
SECTION PLAT

330 Ft. from N. Line

_____ Ft. from S. Line

_____ Ft. from E. Line

330 Ft. from W. Line

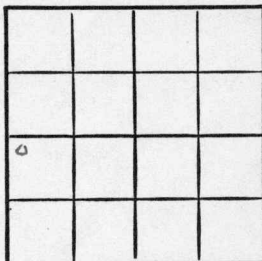

Barber County

RECORD

Location _____

Cased _____ in., _____ ft.

Rig up _____

Sand _____

Drilling and Remarks:

Gas _____

Oil _____

Total Depth 4839

PRODUCTION

1st 24 hrs. Nat. _____

1st 24 hrs. after shot _____

Gas _____ Cu. Ft.

Dry Hole _____

Abandoned _____

Date

JUN 4 1947 19 S. J. LEWIS Scout