

KANSAS

FORM 51 10M 12-46 PETROL


Grant

Section 5 Township 30 Range 36-W

Well No. 4 Alford

Company United Prod.

Hugoton Pool

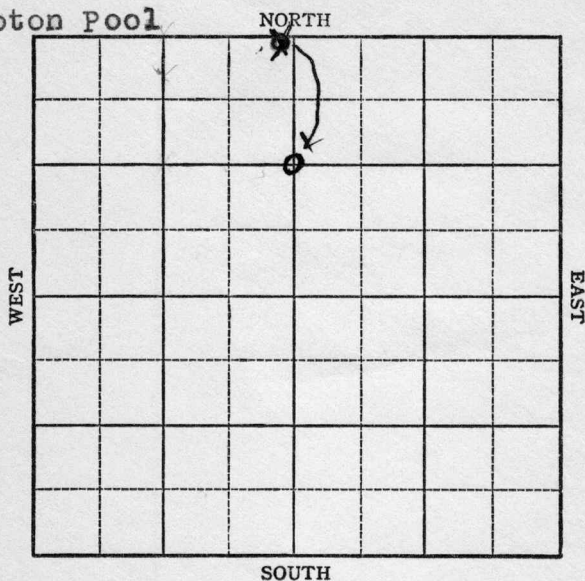

KANSAS Grant

Sec. 5 Twp. 30 R. 36W

Well No. #4 Alford Farm

United Prod. Company
Hugoton

1320 Ft. from N. Line


1320 Ft. from S. Line

2640
40 Ft. from E. Line

 Ft. from W. Line

C N L Sec.

C N 1/2 Sec.

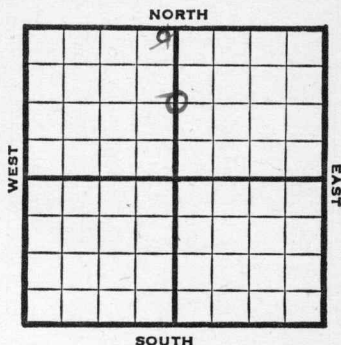

1947 Elev. 3045' **REPORT**

9/24 10/1 10/8 10/15 10/22 10/29 11/12	Location 10" @ 636' 2500 fsg. TD 2526' 7" @ 2525' RUST TD 2720 225' of 5" perf liner @ 2720' Acid 14,000 7" @ 2525' 225' of 5" Perf liner @ 2720' Acid 14,000 Gas 18,950,000 Rock Pressure 409# Total Depth 2720'
---	---

COMPLETED

Map No. _____ Sec. 5 Twp. 30 R. 36W

Well No. 4 Alford

United Prod. Company

C N L Sec. WEST REPORT Contractor


SECTION PLAT

_____ Ft. from N. Line

1320 Ft. from S. Line

40 Ft. from E. Line

_____ Ft. from W. Line

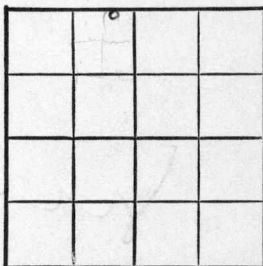

Grant County

Location X

Rig up _____

Drilling and Remarks:

RECORD

Cased _____ in., _____ ft.

Sand _____

Gas _____

Oil _____

Total Depth _____

PRODUCTION

1st 24 hrs. Nat. _____

1st 24 hrs. after shot _____

Gas _____ Cu. Ft.

Dry Hole _____

Abandoned _____

Date

SEP 24 1947

19

S. J. LEWIS

Scout

Map No. 0 Sec. 5 Twp. 30 R. 36W

Well No. 4 Alford

United Prod. Company

CORRECTION

Contractor

C $N\frac{1}{2}$ Sec.


SECTION PLAT

1320 Ft. from N. Line

 Ft. from S. Line

2640 Ft. from E. Line

 Ft. from W. Line

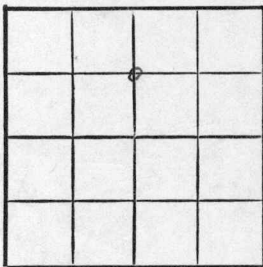

Grant County

Location

Rig up

Drilling and Remarks:

Reported

NE NW

RECORD

Cased in., ft.

Sand

Gas

Oil

Total Depth

PRODUCTION

1st 24 hrs. Nat.

1st 24 hrs. after shot

Gas Cu. Ft.

Dry Hole

Abandoned

Date

OCT 8 1947 19

S. J. LEWIS Scout

Map No. ✓ Sec. 5 Twp. 30 R. 36W

Well No. 4 Alford

United Prod. Company


COMPLETE

Contractor

C $N\frac{1}{2}$ Sec.

E13045

SECTION PLAT

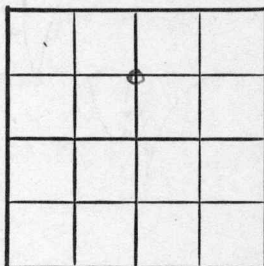

1320 Ft. from N. Line

_____ Ft. from S. Line

2640 Ft. from E. Line

_____ Ft. from W. Line

Grant County

Location _____

Rig up _____

Drilling and Remarks:

*7" @ 2525.
225' 2 1/5" Pay liner
@ 2720
14000 acid
18,950,000 Gas
409 # R/B*

RECORD

Cased _____ in., _____ ft.

Sand _____

Gas _____

Oil _____

Total Depth 2720

PRODUCTION

1st 24 hrs. Nat. _____

1st 24 hrs. after shot _____

Gas _____ Cu. Ft.

Dry Hole _____

Abandoned _____

Date

NOV 12 1947

19

S. J. LEWIS

Scout