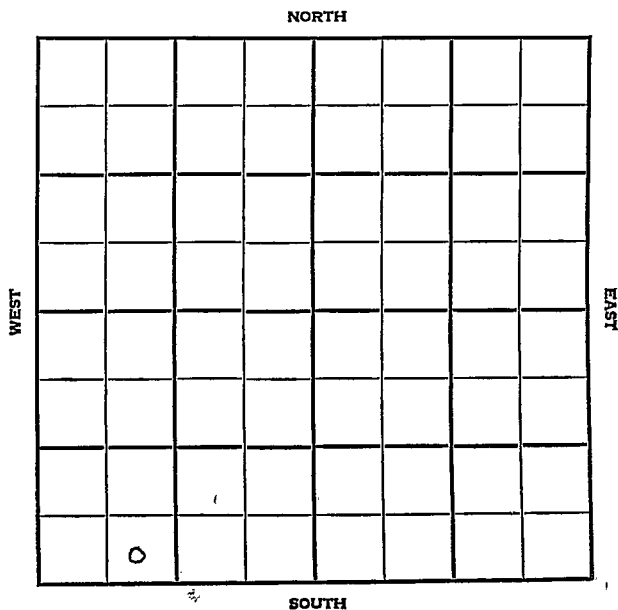


Section 5 Township 30 Range 2 WWell No. #1 Van AllenCompany Ted Ferrier

Sumner

KANSAS

SEC.	TWP.	R.
5	- 30	2W

WELL NO.

#1 Van Allen

FARM

COMPANY

☒ Ted Ferrier

CONTRACTOR

McKnab & Lindsey

Latta Ext.


_____ Ft. from N. Line

_____ Ft. from S. Line

_____ Ft. from E. Line

_____ Ft. from W. Line

SE SW SW

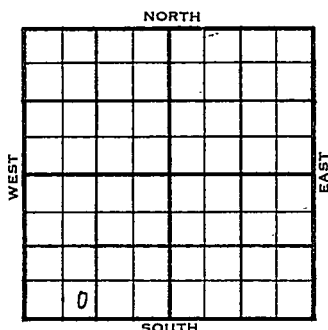

	ELEVATION	REPORT
1956	1309	
2-29	RUR	
4-18	Comm. 2-26-56 8 5/8" @ 122 DST 3139-51 op 1 hr. rec. 60' ocm, 60' msw, 1070/20" DST 3172-84 op 1 hr. rec. 60' gocm, 210' gassy oil, 45' msw, 990# DST 3647-61 op 1 hr. gas in 18 min. rec. 90' mcw, 700# DST 4057-65 op 2 hrs. 200' GIP rec. 40' socm, 50' sw, 1500/20" 5 1/2" @ 3268 CO to 3180, 24/ 3172-76 S/ mud, oil & wtr., 500 A S/ 20 boph, 8 hrs., P/ 25 bopd, Comp. 116 bopd, 3% wtr. Tp. 1954 H. 2386 KC 3014 BKC 3213 M. 3627 S. 4053 TD 4169'	

COMPLETED

County Sumner Elev. _____
 Sec. 5 Twp. 30 Rge. 2W
 Company Ted Verrier
 Farm Name Van Allen No. 1

TOPS	DEPTH	LOG	DATUM	Loc. in Sec.
Anh.				SE SW SW
Tp.				
H.				
Tr.				
Dg.				
Bl.				
L.				Geol.
K.C.				Contr.
B.K.C.				McKnab & Linds
Ce.				
C.				Pool
M.				Latta Ext.
M.				
K.				
Mz.				
Mq.				
V.				
S.				
S.				
A.				
R.				
Pe.				
G.				
T.D.				

Date Comm.
 R U R

20

FIRST REPORT

FEB 29 '56

Co.

F

No.

Sec.

T.

R.

MAR 7 1956
R. G.

County Sumner Elev. 1309
 Sec. 5 Twp. 30 Rge. 2W
 Company Ted Ferrier
 FarmName Van Allen No. 1

TOPS	DEPTH	LOG	DATUM	Loc. in Sec.
Anh.				SE SW SW
TP.	<u>1954</u>			
H.	<u>2386</u>			
Tr.				
Dg.				
BL.				
L.				Geol.
K.C.	<u>3014</u>		<u>1705</u>	
B.K.C.	<u>3213</u>		<u>1904</u>	Contr.
Ce.				McKnab & Lind
C.				
M.	<u>3627</u>		<u>2318</u>	Pool
M.				Latta Ext.
K.				
Mz.				
Mq.				
V.				
S.	<u>4053</u>		<u>2744</u>	
S.				
A.				
R.				
PE.				COMPLETE
G.				
T.D.	<u>4169</u>			

Date Comm. 2-26-56

APR 18 1956

8 5/8" @ 122/ DST 3139-51 open 1 hr.

rec. 60' ocm 60' msW 1070/20"

DST 3172-84 open 1 hr. rec. 60' gocm

210' gassy oil 45' msW 990#

DST 3647-61 open 1 hr. gas in 18 min.

rec. 90' mcw 700# DST 4057-65

open 2 hr. 200' GIP - rec. 40' socm

50' SW 1500/20" 5 1/8" @ 3268

OVER

APR 26 1956

R. G.

GO to 3180 2 1/2 / 3172-76 S/ mud, oil & wtr.
500 A S/ 20 bopd 8 hr. P/ 25 bopd
Comp. 116 bopd 3% wtr.