Kingman **KANSAS**

SECTION 5 TOWNSHIP 30S RANGE 7W

WELL NO. #1-B Render "B"

COMPANY Pickrell

NORTH SW SW NW

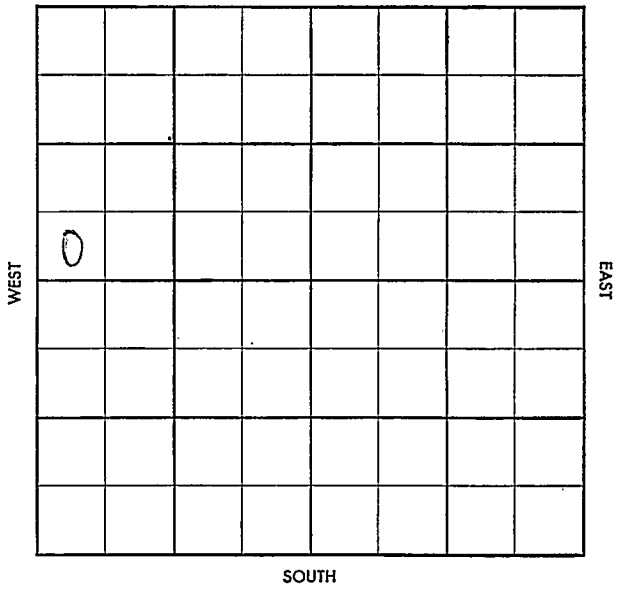

FORM 504-3 SUNRAY

27

WILDCAT

S-513-A

CO. Kingman ELEV.

SEC. 5- TWP. 30S RGE. 7W

COMPANY Pickrell NO. 1-B

FIRST REPORT

NOV 6 '57

FARM Render "B"

LOC. SW SW NW Mag. - FO

GEOL.

CONTR. Pickrell Drlg.

POOL Wildcat

SPUD 11-2-57

8" 160 w/125 sx;

D 1645

CO. LSE. NO. SEC. TWP. RGE.

CORRECTION

S-513-A

CO. Kingman ELEV. 1498 DF

SEC. 5- TWP. 30S RGE. 7W

COMPANY Pickrell NO. 1-

NOV 20 '57

ABANDONED

FARM Render "B"

LOC. SW SW NW Mag. - FO

GEOL.

CONTR. Pickrell Drlg.

POOL Wildcat

SPUD 11-2-57

8" 160 w/125 sx;

D 1645 Ø3813

Hb 3126 Lsg 3360

M 4140

DST 4143-63

90" g/45" rec

100' gcm BHP 1315-570

DST 4163-97 90" 200' O&GCM

75' W BHP 1520-1245 DST

4197-4243 90" 580' O&GCM

80' SW BHP 1610-1245

RTD 4243 run log

Log L 3358 M 4138

D&A

CO. LSE. NO. SEC. TWP. RGE.