
Kingman **KANSAS**

SECTION 5 TOWNSHIP 30 RANGE 7W

WELL NO. #1 Young "B"

COMPANY Pickrell Drlg.

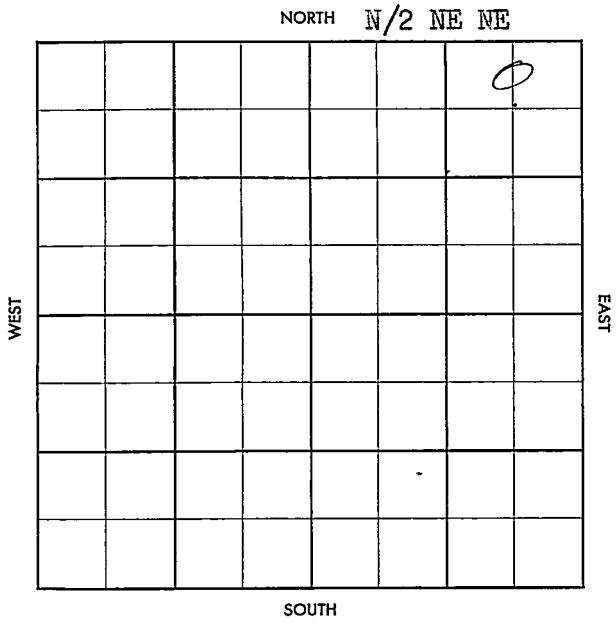

FORM 513 SUNRAY

WILDCAT

County Kingman Elev.

Sec. 5 Twp. 30 Rge. 7W

Company Pickrell Drlg.

Farm Name Young "B" No. 1

TOPS	DEPTH	LOG	DATUM
Anh.			
Tp.			
H.			
Tr.			
Dg.			
Bl.			
L.			
K.C.			
B.K.C.			
Ce.			
C.			
M.			
M.			
K.			
Mz.			
Mo.			
V.			
S.			
S.			
A			
R.			
P€.			
G.			
T.D.			

Loc. in Sec. N/2 NE NE

Geol.

Contr. Oc. Tools


Pool Wildcat

MAR 19 '57

FIRST REPORT

Date Comm. 3-11-57 Amerada - (DHM)

8" @ 160/90, drlg. 600

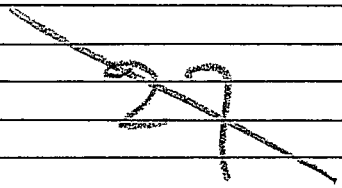

Co. Lse. No. Sec. T. R.

FORM 513 SUNRAY

County Kingman Elev. 1495

Sec. 5 Twp. 30 Rge. 7W

Company Pickrell Drlg.

Farm Name Young "B" No. 1

TOPS	DEPTH	LOG	DATUM
Anh.			
Tp.			
H.	3114		
Tr.			
Dg.			
Bl.			
L.	3336		
K.C.			
B.K.C.			
Ce.			
C.			
M.	4132		
M.			
K.			
Mz.			
Mq.			
V.			
S.			
S.			
A			
R.			
P€.			
G.			
T.D.	4230		

Loc. in Sec. N/2 NE NE

Geol.

Contr. Co. Tools

Pool Wildcat

MAR 27 '57

ABANDONED

Date Comm. 3-11-57 Amerada - (DHM)

8" @ 160/90, drlg. 600 MAR 20 '57 D 3490

MAR 27 57 DST 4136-65 op 90" rec 150' GCM BHP 1155 - 55/20"

DST 4170-4230 op 1hr rec 90' Md BHP 140/20"

D & A.

Co. Lse. No. Sec. T. R.