Grant


FORM 51

KANSAS

Section 6 Township 30 Range 37W

Well No. #1 Hoffman

Company Hugoton Prodl

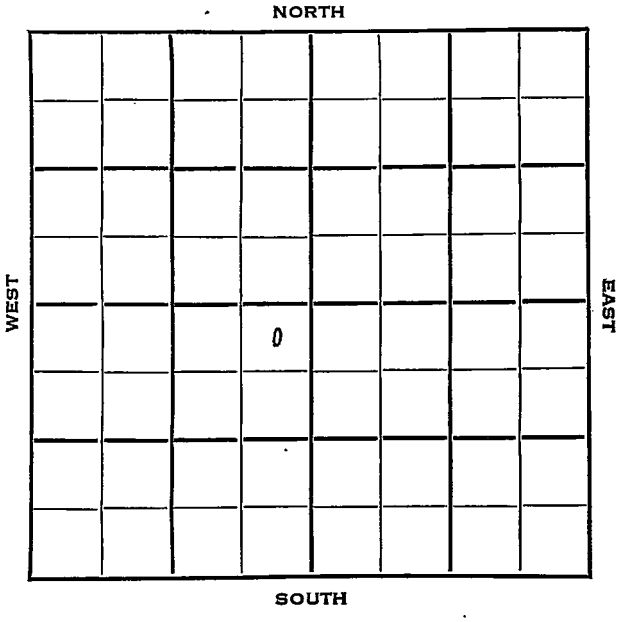

Grant KANSAS

SEC.	TWP.	R.
6	30	37W ✓

WELL NO.
1 Hoffman FARM

COMPANY
Hugoton Prod.

CONTRACTOR
Moran

Hugoton Pool


200 Ft. from N. Line

Ft. from S. Line

200 Ft. from E. Line

Ft. from W. Line

NE NE SW

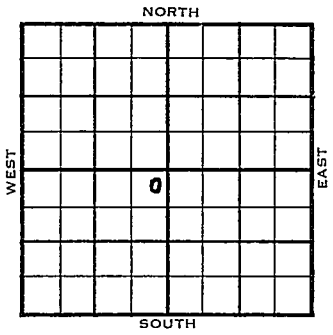

1954	ELEVATION 3121'	REPORT
3/24	Location	
4/7	10" @ 578' TD 2408' 7" @ 2395'	
4/28	Spud 3-27-54 Gas well TD 2631 10" @ 578 Hol. 2351' Her. 2393' Kri. 2415 Win. 2484 Ft. Riley 2542 TD 2631 5" liner @ 2631 7" @ 2395 Comp. 6,160,000 gas. **COMPLETED**	

DX-78

FORM 275 FOR SALE BY KANSAS BLUE PRINT CO.

County Grant State Kansas

Sec. 6 (Blk. Twp.) 30 (Sur. Rge.) 37W Map No.

Operator Hugoton Prod.

Well No. 1 Farm Hoffman

Elev. Location NE NE SW

FIRST REPORT

200 Ft. From N Line SW

200 Ft. From E Line Quarter

MAR 24 1954

1st. Report

Completion

Remarks

Moran - Contr.

Spudding Date

Drlg. Data Hugoton Pool

Location

J. G. McGEHEE

FORM 275 FOR SALE BY KANSAS BLUE PRINT CO.


County Grant State Kansas

Sec. 6 (Blk. Twp.) 30 (Sur. Rge.) 37W Map No.

Operator Hugoton Prod.

Well No. 1 Farm Hoffman

Elev. 3121 Location NE NE SW

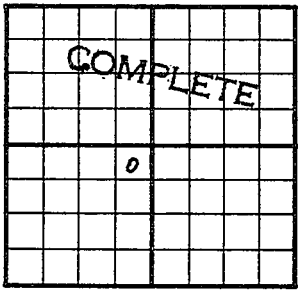

200 Ft. From N Line SW

200 Ft. From E Line Quarter

1st. Report

Completion APR 28 1954

Remarks Hugoton Pool

Moran - Contr.

Spudding Date 3-27-54

Drlg. Data Gas well TD 2631

10" @ 578 Hol. 2351 Her. 2393

Kri. 2415 Win. 2484 Ft. Riley 2542

TD 2631 5" liner @ 2631 7" @ 2395

Comp. 6,160,000 gas

J. G. McGEHEE