

Grant County

Hugoton Pool


FORM 51 IOM 12-46 PETROL *

KANSAS

Section 6 Township 30 Range 38N

Well No. 1' Sullivan

Company Stanolind

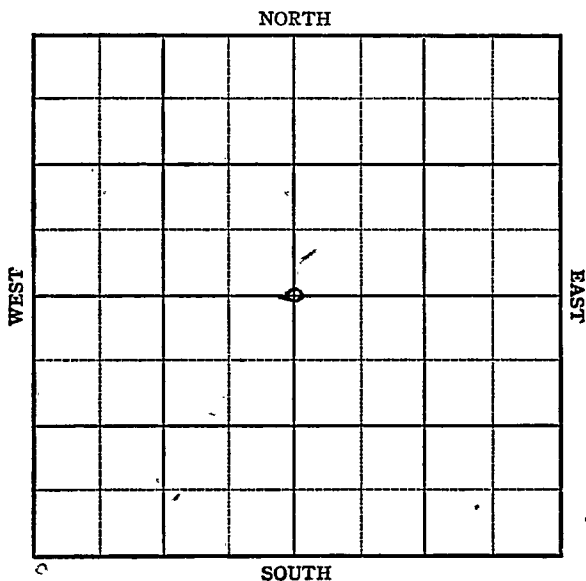

KANSAS

Grant ☒

Sec. 6 Twp. 30 R. 38 ~~W~~


Well No. #1 Sullivan Farm
Stanolind Company

2640 Ft. from N. Line

 Ft. from S. Line

2640 Ft. from E. Line

 Ft. from W. Line

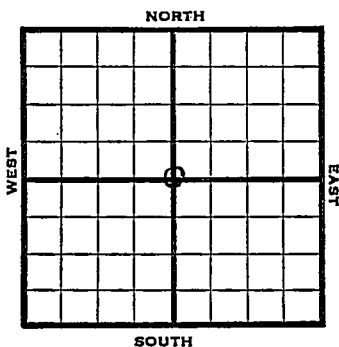

C Sec

1947 Elev. 3147' REPORT

3/5 8" @ 593
WOC

3/11 TD 2563'
5" @ 2532
RUST

3/26 5" @ 2532'
Perf.
20000 Acid
7,145,000 Gas
415# RPE
TD 2570'

COMPLETED

Map No. _____ Sec. 6 Twp. 30 R. 38W

Well No. 1 Sullivan

Stanolind Company

FIRST REPORT

Contractor _____

C Sec.


SECTION PLAT

2640 Ft. from N. Line

_____ Ft. from S. Line

2640 Ft. from E. Line

_____ Ft. from W. Line

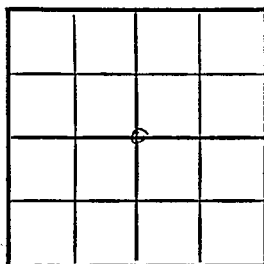

Grant County

Location _____

Rig up _____

Drilling and Remarks:

8" @ 593 WOC

RECORD

Cased _____ in., _____ ft.

Sand _____

Gas _____

Oil _____

Total Depth _____

PRODUCTION

1st 24 hrs. Nat. _____

1st 24 hrs. after shot _____

Gas _____ Cu. Ft.

Dry Hole _____

Abandoned _____

Date

MAR 5 1947 19 S. J. LEWIS Scout

Kansas

Map No. _____ Sec. 6 Twp. 30 R. 38WWell No. 1 Sullivan

Stanolind

Company

COMPLETE

Contractor


C Sec.

E 13147
SECTION PLAT2640 Ft. from N. Line

_____ Ft. from S. Line

2640 Ft. from E. Line

_____ Ft. from W. Line

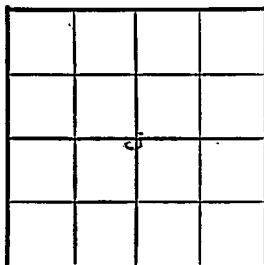

Grant County

Location _____

Rig up _____

Drilling and Remarks:

5702532
214
20060 acid

7,145,000 Acc415 R/R

RECORD

Cased _____ in., _____ ft.

Sand _____

Gas _____

Oil _____

Total Depth 2520

PRODUCTION

1st 24 hrs. Nat. _____

1st 24 hrs. after shot _____

Gas _____ Cu. Ft.

Dry Hole _____

Abandoned _____

Date

MAR 26 1947 19

S. J. LEWIS Scout