


Section 7 Township 30S Range 31W

Well No. #2 Osborne

Company Michaelis Dlg

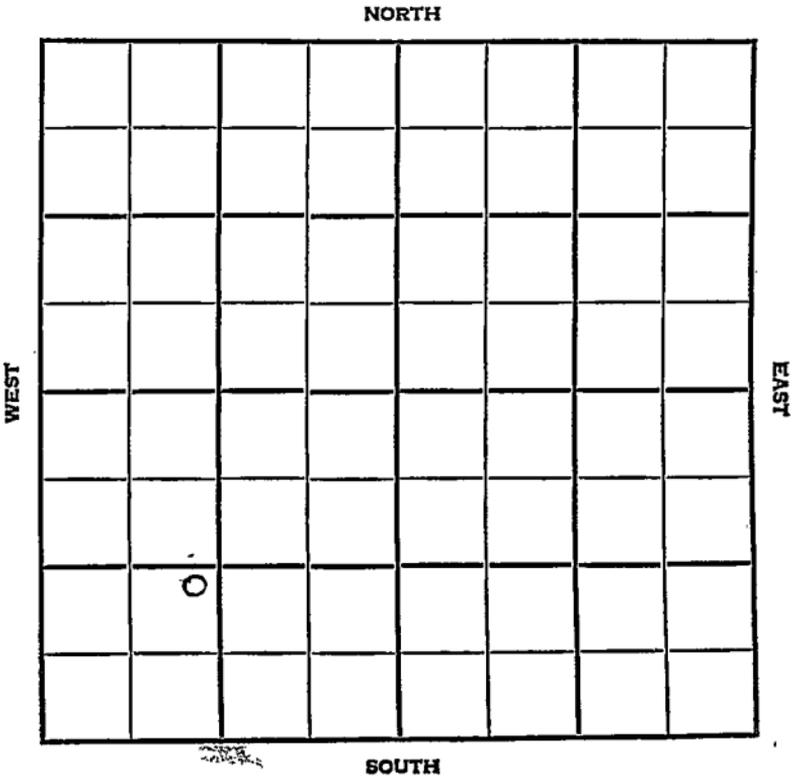


SEC.	7	TWP.	30	R.	31W
------	---	------	----	----	-----

WELL NO. #2 Osborne FARM

COMPANY Michaelis Drlg.

CONTRACTOR

1365 Ft. from N. Line
 _____ Ft. from S. Line
 1365 Ft. from E. Line
 _____ Ft. from W. Line
 NE SW SW

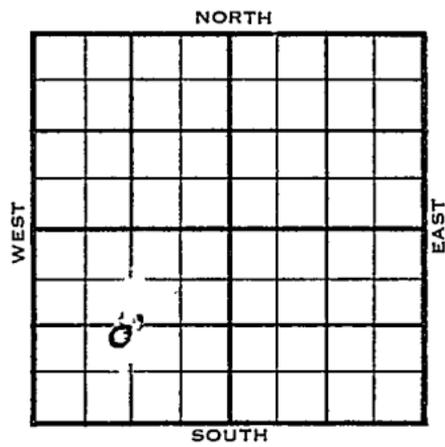

1955	ELEVATION	REPORT
	2855	

8/31 M I R

11/2
 Comm 8-30-55
 8 5/8" @ 506/300
 5 1/2" @ 3724 w/300
 Herr 2641
 U Kri 2667
 L Kri 2698
 TD 3725
 CO 16/2706-10 500 A wtr SP 2687
 40/2670-80 4000A frac 1,646 mcf/g
 Comp 3 mcf/gpd 440#

COMPLETED

County Haskell Elev. _____
 Sec. 7 Twp. 30 Rge. 31W
 Company Michaelis Drilg.
 Farm Name Osborne No. 2

TOPS	DEPTH	LOG	DATUM
Anh.			
Tp.			
H.			
Tr.			
Dg.			
Bl.			
L.			
K.C.			
B.K.C.			
Ce.			
C.			
M.			
M.			
K.			
Mz.			
Mo.			
V.			
S.			
S.			
A.			
R.			
PE.			
G.			
T.D.			

Loc. in Sec. _____
NE SW 1/4
1365' NL
1365' EL
 Geol. _____
 Contr. _____
 Pool _____

FIRST REPORT	

Date Comm. MIR

[Handwritten signature]

Co.
Lse.
No.
Sec.
T.
R.

County Haskell Elev. 2855
 Sec. 7 Twp. 30 Rge. 31W
 Company Michaelis Drlg.
 Farm Name Osborne No. 2

TOPS	DEPTH	LOG	DATUM
Anb.			
Tr.			
H. <u>Heard</u>		<u>2641</u>	
Tr. <u>U. Knit</u>		<u>2667</u>	
Dg. <u>L. Knit</u>		<u>2698</u>	
Bl.			
L.			
K.C.			
B.K.C.			
Ce.			
C.			
M.			
M.			
K.			
Mz.			
Ma.			
V.			
S.			
S.			
A			
R.			
PE.			
G.			
TD.	<u>3725</u>		

Loc. in Sec. _____
 NE SW SW
 1365' NL
 1365' EL
 Geol. _____
 Contr. _____
 Pool _____

COMPLETE		

Date Comm. 8-30-55 NOV 2 1955
8 5/8" @ 506/300 5 1/2" @ 3724/300
CO 16/ 2706-10 500 A wtr. SP 2687
40/ 2670-80 1000 A frac 1,646 mcfg
Comp. 3 mcfgpd W10#

Co. Lse. No. Sec. T. R.