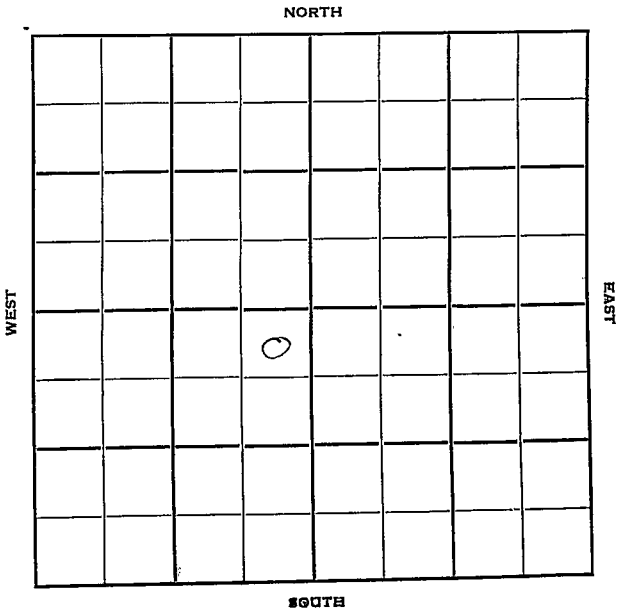


Section 7 Township 30 Range 32WWell No. #1 McCoyCompany Champlin Ref.

Sec. 7 Twp. 30 R. 32W

Well No. #1 McCoy Farm

Champlin Ref. Company


Hugoton Pool Contractor

330' Ft. from N. Line

 Ft. from S. Line

330' Ft. from E. Line

 Ft. from W. Line

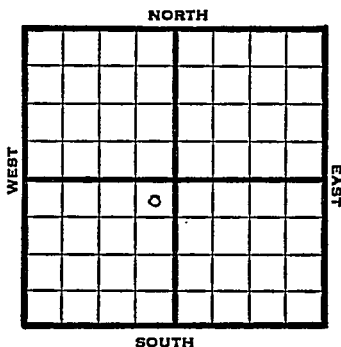

NE NE SW

1950 Elev. 2930' REPORT

1/25 Location

3/22 Location Aband.
Aband.

ABANDONED

Kansas

Hugoton Pool

Map No. _____ Sec. 7 Twp. 30 R. 32WWell No. 1 McCoy

Champlin Ref. _____ Company _____

Contractor _____

NE NE SW

El. 2930


SECTION PLAT

330 Ft. from N. Line

_____ Ft. from S. Line

330 Ft. from E. Line

_____ Ft. from W. Line

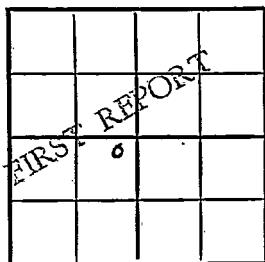

Haskell County

RECORD

Location X

Cased _____ in., _____ ft.

Rig up _____

Sand _____

Drilling and Remarks:

Gas _____

Oil _____

Total Depth _____

PRODUCTION

1st 24 hrs. Nat. _____

1st 24 hrs. after shot _____

Gas _____ Cu. Ft.

Dry Hole _____

Abandoned _____

Date

J. E. TYRA

JAN 25 1950 19

Scout

Map No. _____ Sec. 7 Twp. 30 R. 32WWell No. 1 McCoy

_____ Champlin Ref. _____ Company

_____ Contractor

NE NE SW

E 1. 2930


SECTION PLAT

330 Ft. from N. Line

_____ Ft. from S. Line

330 Ft. from E. Line

_____ Ft. from W. Line

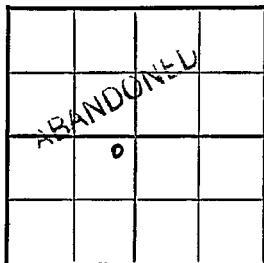

Haskell County

Location _____

Rig up _____

Drilling and Remarks:

Location abel.

RECORD

Cased _____ in., _____ ft.

Sand _____

Gas _____

Oil _____

Total Depth _____

PRODUCTION

1st 24 hrs. Nat. _____

1st 24 hrs. after shot _____

Gas _____ Cu. Ft.

Dry Hole _____

Abandoned _____

Date

MAR 22 1950

19

J. E. TYRA

Scout