

Section 7 Township 30 Range 32WWell No. #1 McCoyCompany Champlin Ref.

NORTH

			0				

WEST

EAST

SOUTH

Haskell

KANSAS

Sec. 7 Twp. 30 R. 32W ☒

Well No. #1 McCoy Farm

Champlin Refg. Company

Hugoton Pool Contractor


 Ft. from N. Line

2310' Ft. from S. Line

 Ft. from E. Line

2310' Ft. from W. Line

NE SW

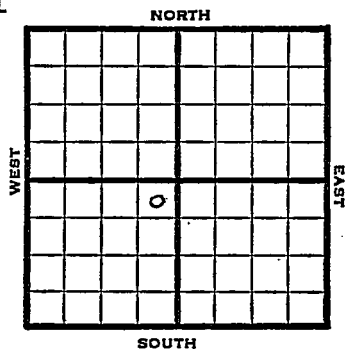

1950	Elev 2913	REPORT
6/14	Spud 6-10-50 10" @ 730'	
8/16	10" @ 730 Her 2649 Win 2740 7" @ 2780 TD 2780 156/2742-68 228/2694-2732 96/2671-87 80/2649-59 30000 total acid Comp 9,688,000 gas Completed	Krider 2671
	COMPLETED	

Map No. _____ Sec. 7 Twp. 30 R. 32WWell No. 1 McCoy

_____ Champlin Ref. _____ Company

_____ Contractor

NE SW

SECTION PLAT

_____ Ft. from N. Line

2310 Ft. from S. Line

_____ Ft. from E. Line

2310 Ft. from W. Line

Haskell County

Location _____

Rig up _____

Drilling and Remarks:

Spud 6-10-50

10" @ 730

RECORD

Cased _____ in., _____ ft.

Sand _____

Gas _____

Oil _____

Total Depth _____

PRODUCTION

1st 24 hrs. Nat. _____

1st 24 hrs. after shot _____

Gas _____ Cu. Ft.

Dry Hole _____

Abandoned _____

Date

JUN 14 1950 19 J. E. TYRA Scout

J. E. TYRA