

Well No. 1- Slutter Farm
Ellis et al Company

WEST

0

EAST

SOUTH

[illegible]

Cased _____ in. _____ ft.
 Sand _____
 Gas _____
 Oil _____
 Total Depth _____

1

2

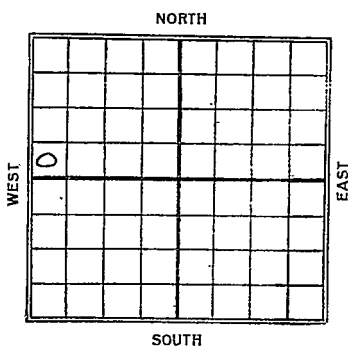
523

524

525

52

1st 24 hrs. Nat. _____
1st 24 hrs. after shot _____
Gas _____ cu. ft.
Dry Hole _____
Abandoned _____

Map No. K Sec. 7 Twp. 30 R. 1^WWell No. 1 Shutter Farm
Ellis et al Company Ft. from N. Line300 Ft. from S. Line Ft. from E. Line300 Ft. from W. LineBeneas

Date

REPORT

192410/8 Spudded & S.D.11/1712/1719251/216/5T.L. 3690 D+Abd 3707

Map No. **KANSAS** Sec. **7** Twp. **30**⁺ R. **1 W**Well No. **1 - Shutter****Ellis et al** Company

Contractor

FIRST REPORT

SECTION PLAT

6			

Ft. from N. Line

300' Ft. from S. Line

Ft. from E. Line

300' Ft. from W. Line

Location -----

Rig up -----

Drilling and Remarks:

spudded & S.A.

RECORD

Cased ----- in., ----- ft.

Sand -----

Gas -----

Oil -----

Total Depth -----

PRODUCTION

1st 24 hrs. Nat. -----

1st 24 hrs. after shot -----

Gas ----- Cu. Ft.

Dry Hole -----

Abandoned -----

Date

OCT 8 1924**M. A. BENEAR**

192-----

Scout

MAP No. _____ SEC. 7 TWP. 30 S R. 1 WWELL No. 1 ClintonShawver et al COMPANY

CONTRACTOR

SECTION PLAT

0			

_____ FT. FROM N. LINE

_____ FT. FROM S. LINE

_____ FT. FROM E. LINE

_____ FT. FROM W. LINE

LOCATION _____

RIG UP _____

DRILLING AND REMARKS:

3660-90 ss & dr
 Top Miss at
 3690

RECORD

CASED _____ IN. _____ FT.

SAND _____

GAS _____

OIL _____

TOTAL DEPTH 370'

PRODUCTION

1ST 24 HRS. NAT. _____

1ST 24 HRS. AFTER SHOT _____

GAS _____ CU. FT.

DRY HOLE ☒ABANDONED ☒

DATE

2/29 1925 SCOUT

Map No. **KANSAS** Sec. **7** Twp. **30** R. **1W**

Well No. **1 Shutter**
Ellis et al. Company

Contractor

ABANDONED SECTION PLAT

_____ Ft. from N. Line

300' Ft. from S. Line

_____ Ft. from E. Line

300' Ft. from W. Line

0			

Location _____

Rig up _____

Drilling and Remarks:

Tap, L. 3690
L + 92707

RECORD

Cased _____ in., _____ ft.

Sand _____

Gas _____

Oil _____

Total Depth _____

PRODUCTION

1st 24 hrs. Nat. _____

1st 24 hrs. after shot _____

Gas _____ Cu. Ft.

Dry Hole _____

Abandoned _____

Date

JUN 5 1925

M. A. BENEAR

192

Scout