

Section 7 Township 30 Range 37WWell No. #1 CornwellCompany Hugotn Prod.

NORTH

			0				

WEST

EAST

SOUTH

Grant

KANSAS

Sec. 7 Twp. 30 R. 37W

Well No. #1 Cornwell Farm

Hugoton Prod. Company

Moran Drlg. -Contr. Contractor

Hugoton Pool


 Ft. from N. Line

2900' Ft. from S. Line

2830' Ft. from E. Line

 Ft. from W. Line

SE SE NW

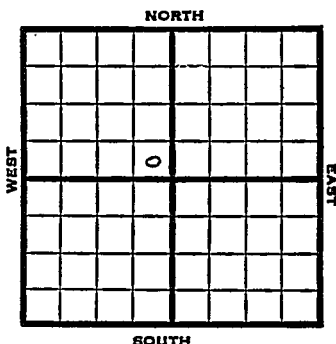

1951

Elev. 3120' REPORT

3/7

8/15

Location

Spud 5-4-51

Gas Well TD 2645

10" @ 556

7" @ 2399

TD 2645

Hol. 2363 Her. 2402

Krider 2421-82


Win. 2487-2530

Ft. Riley 2548-98

15,000 A Comp. 28,100,000 gas

412#

COMPLETED

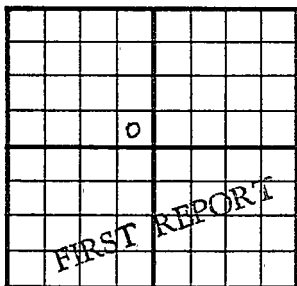County Grant State KansasSec. 7 (Blk. Twp.) 30 (Sur. Rge.) 37W Map No.Operator Hugoton Prod.Well No. 1 Farm CornwellElev. Location SE SE NW2900 Ft. From S Line NW2830 Ft. From E Line Quarter1st. Report MAR 7 1951

Completion

Remarks

Moran Drlg. - Contr.

Spudding Date

Drlg. Data Hugoton Pool

Location

J. E. TYRA

J. E. TYRA