


Stanton

KANSAS

SECTION 7 TOWNSHIP 30S RANGE 42W

WELL NO. #1 Kilgore

COMPANY Robert J. Beams, Dallas, Texas

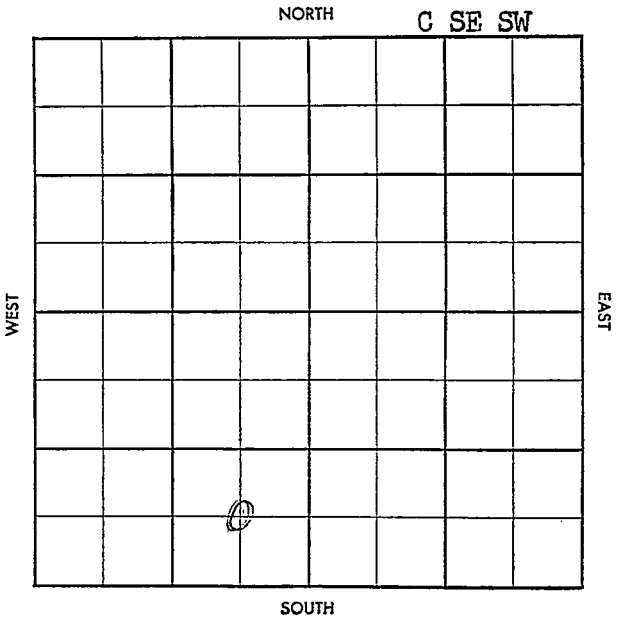

Top Foot
 Co. Facet

S-518B

County Stanton Elev. 3553 or 3556
 Sec. 7 Twp. 30 Rge. 42W
 Company Robert J. Beams, Dallas, Texas
 Farm Name Kilgore No. 1

TOPS	DEPTH	LOG	DATUM
Anh <u>Lcomp</u>	<u>3472</u>	<u>3468</u>	
Tr.			
H.	<u>3568</u>	<u>3567</u>	
Tr.	<u>3595</u>	<u>3593</u>	
Dg.			
B.L.			
L.	<u>3640</u>	<u>3639</u>	
K.C. <u>max</u>	<u>4225</u>	<u>4235</u>	
B.K.C. <u>max</u>		<u>4989</u>	
Ce. <u>L. Max</u>	<u>5352</u>		
C.		<u>5419</u>	
M.			
M.			
K.			
Mz.			
Mq.			
V.			
S.			
S.			
A.			
Pf.			
G.			
T.D.	<u>5438</u>	<u>5439</u>	

Loc. in Sec. C SE SW
 Geol. _____
 Contr. _____
 Rine # 1
 Pool _____
Sparks

ABANDONED
 JUL 9 '58
 0

Date Comm. 6-15-58 (Amerada - FO)
 Location JUN 11 '58 JUN 18 '58 Ø 1130 JUN 25 '58
8" 1514/750 Ø 3475 JUL 2 '58 Ø 4874
JUL 9 '58 DST 5284 - 5348 Ø 20"
6" M FP 20 BHP 550/20" Log

D6A