

Kiowa

KANSAS

SECTION 8 TOWNSHIP 30 RANGE 16 W

WELL NO. #1 Rice

COMPANY L. C. Smitherman

NORTH

WEST

EAST

SOUTH

0

Kiowa

KANSAS


SEC.	TWP.	R.
8	30	16W

WELL NO. #1 Rice FARM

COMPANY L. C. Smitherman

CONTRACTOR Co Tools Wildcat

_____ Ft. from N. Line
 _____ Ft. from S. Line
 _____ Ft. from E. Line
 _____ Ft. from W. Line

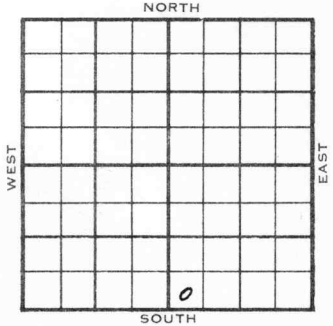

SW SW SE

1955	ELEVATION 1849'	REPORT
------	--------------------	--------

11/9 Loc

12-7 Comm. 11-11-55
 8 5/8" @ 363/300
 DST 4606-14 op 1 hr. rec. 72' gcm, 0/20"
 DST 4608-45 op 1 hr. rec. 72' mud, 0/20"
 D & A
 H. 3836
 Dg. 3879
 BL 4005
 L. 4025
 BEC 4460
 Marm 4480
 C. 4588
 M. 4602
 Cherty 4676
 TD 4737

ABANDONED

County Kiowa Elev. 1819 Co. 16W
 Sec. 8 Twp. 30 Rge. 16W
 Company L. C. Smitherman
 FarmName Rice No. 1

TOPS	DEPTH	LOG	DATUM	Loc. in Sec.
Anh.				SW SW SE
Tr.				
H.	3836		1987	
Tr.				
Dg.	3879		2030	
Bl.	4005		2156	
L.	4025		2176	Geol.
K.C.				Contr.
B.K.C.	4460		2611	Co. tools
Ce. <u>Mamm</u>	4480		2631	Pool
C.	4588		2739	Wildcat
M.	4602		2755	<div style="border: 1px dashed black; padding: 5px; text-align: center;"> <p>ABANDONED</p> </div>
M.				
K.				
Mz.				
Me.				
V. <u>cherty</u>	4676		2827	
S.				
S.				
A.				
R.				
Pe.				
G.				
T.D.	4737			

Date Comm. 11-11-55 DEC 7 1955
8 5/8" @ 363.300 DST 4606-14 open 1 hr
rec. 72' gcm 0/20" DST 4608-45
open 1 hr. rec. 72' mud 0/20"
 D & A

Co.

Lse.

No.

Sec.

T.

R.