


Section 8 Township 30 Range 15-W

Well No. #1 Moffett

Company Nadel & Gussman

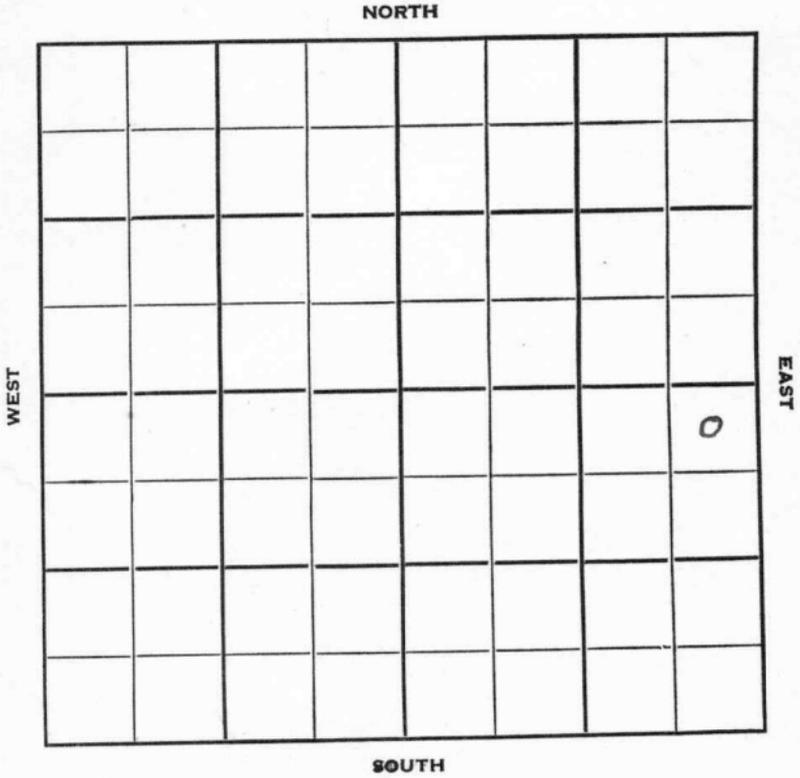

Sec. 8 Twp. 30 R. 15W

Well No. #1 Moffett Farm

Nadel & Gussman Company

Peel Drlg. - Contr. Contractor

Wildcat


330' Ft. from N. Line

_____ Ft. from S. Line

330' Ft. from E. Line

_____ Ft. from W. Line

NE NE SE

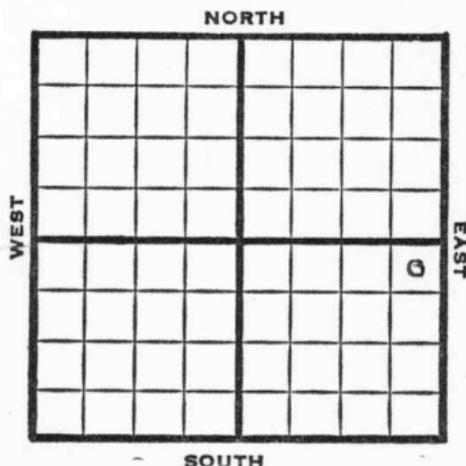

1950 Elev. 1956' REPORT

11/1 Location

1951

2/21 Spud 11-3-50
 D&A TD 4871
 10" @ 553 Heeb. 3851 Br Lime 4046
 Lans. 4065 Massey 4504
 Stain 4513
 DST 4480-4513 opn 1/2 hr Rec. 15' mud
 Viola 4620 DST 4640-65 opn 15 min.
 Rec. 1860' oil Simp. 4765
 Arb. 4845 5" @ 4690
 24/4650-60 S/6 boph 1000 A
 S/15 boph S/222 bo 36/4655-62
 1000 A 30 bwpd SP 4662
 24/4647-52 500 A S/2 1/2 bfph
 1000 A s/6 bfph SP 4635
 16/4500-08 S/Oil & wtr 1000 A
 2 bfph 72/4611-29 SP 4600
 16/4493-97 24/4500-06 12/4506-09
 1000 A S/6 bfph D&A

ABANDONED

