


KANSAS

Grant

Section 8 Township 30 Range 36W

Well No. 3 J. Alford

Company United Prod.

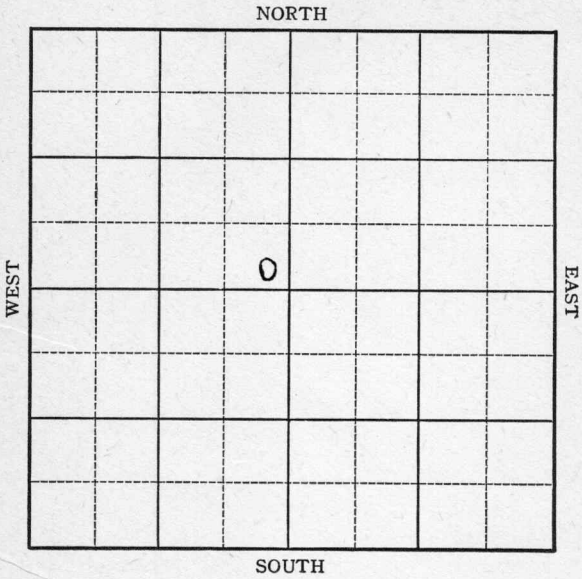

Sec. 8 Twp. 30 R. 36W

Well No. #3 J. Alford Farm
United Prod. Company


Hugoton

 Ft. from N. Line

100 Ft. from S. Line

100 Ft. from E. Line

 Ft. from W. Line

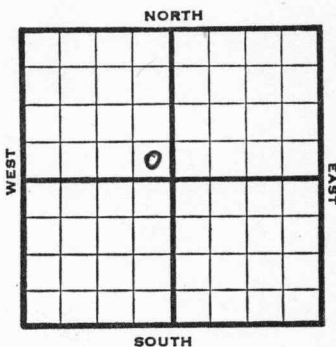

SE NW

REPORT

1946

Elev. 3044

5/29	Location
6/5	10" @ 644 Drlg. 800
6/12	Drlg 2695
6/18	TD 2790 7" @ 2783' RUST
6/26	" " "
7/3	340 shots 2500-2708
7/9	1000 acid
7/16	" "
7/23	" "
7/30	" "
8/6	" "
8/14	7" @ 2783 Perf. 10,000 acid. TD 2790 12,100,000 Gas. 423# R Pr.

COMPLETED

KANSAS

Kansas Pool Name Hugoton Pool

Map No. _____ Sec. 8 Twp. 30 R. 36W

Well No. 3 J. Alford

United Prod. Company

COMPLETED

Contractor

E. B. O'Leary

SECTION PLAT

SE NW

_____ Ft. from N. Line

100 Ft. from S. Line

100 Ft. from E. Line

_____ Ft. from W. Line

Grant County

Location _____

Rig up _____

Drilling and Remarks:

7" @ 2783

Perf.

10000 acid

12,100,000 Gas

423 # R/P

RECORD

Cased _____ in., _____ ft.

Sand _____

Gas _____

Oil _____

Total Depth 2790

PRODUCTION

1st 24 hrs. Nat. _____

1st 24 hrs. after shot _____

Gas _____ Cu. Ft.

Dry Hole _____

Abandoned _____

Date

AUG 14 1946 19 _____

S. J. LEWIS Scout