


Section 8 Township 30 Range 35 W

Well No. # 1 Crail

Company United Prod.

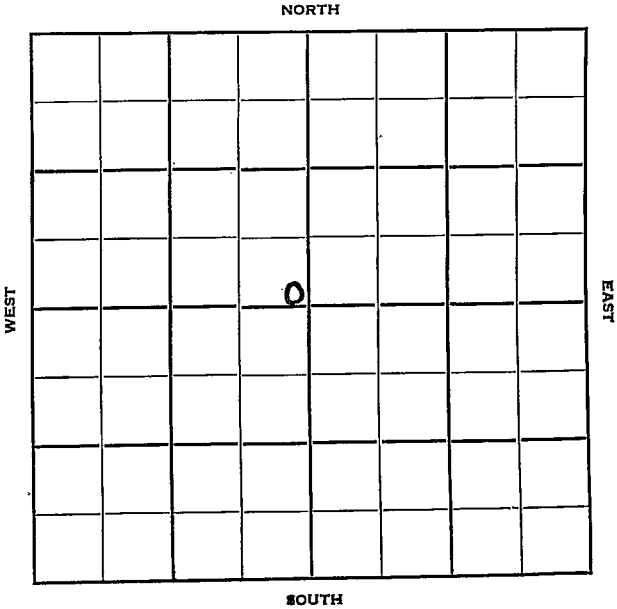

Grant

Sec. 8 Twp. 30 R. 35W

Well No. #1 Crail Farm

United Prod. Company

Hugoton Pool Contractor

Ft. from N. Line

150


Ft. from S. Line

150

Ft. from E. Line

Ft. from W. Line

SE SE NW

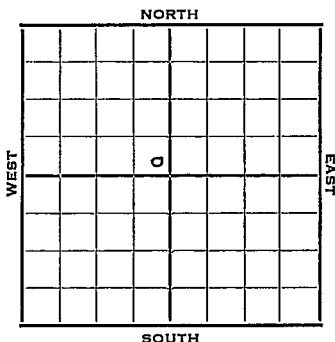

1952 Elev. 2943' REPORT

4/22 Location

4/30 10" @ 511' RTD 2490' 7" @ 2479'
Hol 2433' Her 2475'

5/7 Winfield 2517 Up Ft 2578
Low Ft. 2627 DD 2660 TD
1000 A

5/14 195' of 5" Liner @ 2465'
30,000 A

5/21 6000 A 1 1/4" tub @ 2660

5/28 NR

6/11 "

6/18 Spud 4-22-52
Gas well TD 2660' 10" @ 511
7" @ 2479 TD 2490' Hol. 2433'
Her. 2475' Win. 2517'
Ft. Riley 2578' DD 2660' 1000 A
30,000 A
Comp. 14,402,000 gas

COMPLETED

Scout Cards

Land Small Map.....

Land Wall Map.....

Tracings

France Map

Pierce Map

Misc.....

APR 25 1952

Dirg. Data

Scout Cards *mm*

Land Small Map.....

Land Wall Map *33*.....

Tracings.....

France Map.....

Pierce Map.....

Misc.

JUN 25 1952

Orig. Date