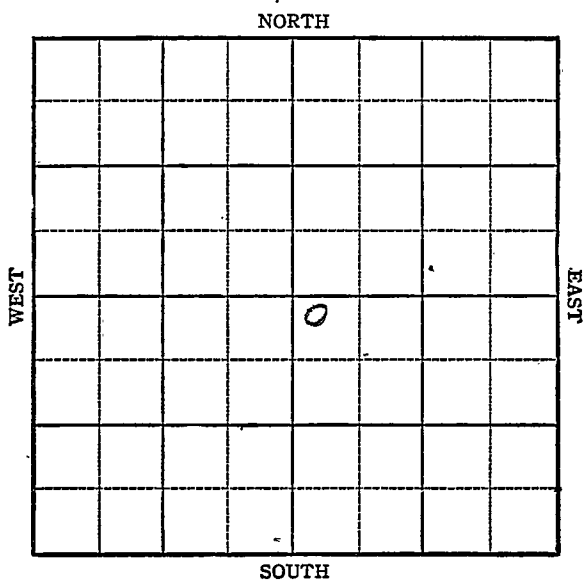


KANSAS

Haskell County

Section 8 Township 30 Range 34WWell No. #1 UnglesCompany United Prod.

KANSAS

Haskell

Sec. 8 Twp. 30 R. 34W

Well No. #2 ~~#1~~ Ungles Farm

United Prod. Company


Hugoton

100 Ft. from N. Line

Ft. from S. Line

Ft. from E. Line

100 Ft. from W. Line

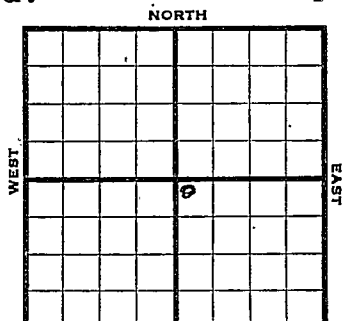

NW SE *E. Sec. 2 994*

SOUTH

1944

REPORT

9/20	Location
9/28	"
10/4	"
10/11	"
10/18	"
10/25	"
11/1	"
11/8	10" @ 614 WOC
11/16	Drlg. 1400'
11/24	7" @ 2520 RUST
11/29	TD 2770 211' off 5" Perf.
	Liner : 2770
12/6	" " " " "
12/14	" " " " "
12/21	" " " " "
12/29	" " " " "
1945	
1/3	8000 acid
1/10	" "
1/17	7" @ 2520
	221' of 5" Perf. liner @ 2770
	8000 acid
	TD 2770
	12,337,000 Gas
	414# R Pr.

COMPLETED

KANSAS

Pool Name HugotonMap No. N/M Sec. 8 Twp. 30 R. 34WWell No. 1 Ungles

United Prod. Company

FIRST REPORT

Contractor

NW SE

SECTION PLAT

100 Ft. from N. Line Ft. from S. Line Ft. from E. Line100 Ft. from W. Line

		0	

HaskellLocation XRig up

Drilling and Remarks:

RECORD

Cased in., ft.Sand Gas Oil Total Depth

PRODUCTION

1st 24 hrs. Nat. 1st 24 hrs. after shot Gas Cu. Ft.Dry Hole Abandoned

Date

SEP 20 1944 19S. J. LEWIS Scout

Pool Name HugotonMap No. 111 Sec. 8 Twp. 30 R. 34 WWell No. 2 Ungles

United Prod

Company

CORRECTION

Contractor

NW SE

SECTION PLAT

		o	

100 Ft. from N. Line

Ft. from S. Line

Ft. from E. Line

100 Ft. from W. LineHaskell County

Location

Rig up

Drilling and Remarks:

Reported as
#1 Ungles

RECORD

Cased _____ in., _____ ft.

Sand _____

Gas _____

Oil _____

Total Depth _____

PRODUCTION

1st 24 hrs. Nat. _____

1st 24 hrs. after shot _____

Gas _____ Cu. Ft.

Dry Hole _____

Abandoned _____

Date

OCT 4 1944

19

S. J. LEWIS Scout

Pool Name Hugoton

Map No. _____ Sec. 8 Twp. 30 R. 34W

Well No. 2 Ungles

United Prod Company

COMPLETED Contractor

NW SE


SECTION PLAT

100 Ft. from N. Line

_____ Ft. from S. Line

_____ Ft. from E. Line

100 Ft. from W. Line

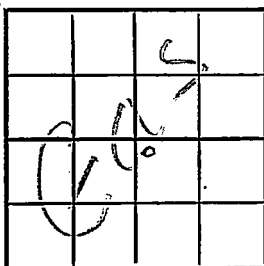

Haskell

Location _____

Rig up _____

Drilling and Remarks:

7" @ 2520

221' of 5" Perf. Liner

@ 2770

8000 acal

12, 837,000 Gas.

414 * R Pl

RECORD

Cased _____ in., _____ ft.

Sand _____

Gas _____

Oil _____

Total Depth 2720

PRODUCTION

1st 24 hrs. Nat. _____

1st 24 hrs. after shot _____

Gas _____ Cu. Ft.

Dry Hole _____

Abandoned _____

Date

JAN 17 1945 19

S. J. LEWIS Scout